



Physical Address: 345 Comanche St.  
Mail to: Box 384 Kiowa, CO 80117  
Ph. 303-621-8672 - Fax 303-621-7749  
www.highprairiesurvey.com


Job # 14006 SNOW KING #13-33

Inv # 2942

High Prairie Surveying of Kiowa, Colorado, in accordance with a request from **Nighthawk Production LLC**, has determined the location of **SNOW KING #13-33 (Top Hole Location)** to be **312 feet FSL**, and **737 feet FWL**, and **SNOW KING #13-33 (Bottom Hole Location)** to be **620 feet FSL**, and **640 feet FWL** (90° off Section lines) of Section **33**, Township **6s**, Range **54w** of the 6th Principal Meridian, **Lincoln County**, Colorado.

Date: Staked on 01/13/14 drawn on 01/14/14.

Re: Staked by Elijah Frane  
Drawn: Drawn by Dustin Cotter

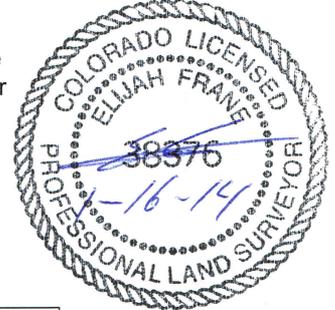

# Topo Exhibit

NIGHTHAWK PRODUCTION LLC.  
SW 1/4 SEC. 33-6S-54W  
SNOW KING #13-33 (THL)  
LINCOLN COUNTY, COLORADO

