

Physical Address: 345 Comanche St.  
 Mail to: Box 384, Kiowa, CO 80117  
 Ph. 303-621-8672 - Fax 303-621-7749  
 www.highprairiesurvey.com

Job # 11094 Ma-State #13

Inv # 2887


High Prairie Surveying of Kiowa, Colorado has in accordance with a request from **Wiepking Fullerton** has determined the location of **Ma-State #13** to be **660 feet FSL**, and **660 feet FEL**, (90° off Section lines) of **SECTION 24**, Township **10s**, Range **56w** of the 6th Principal Meridian, **Lincoln County**, Colorado.

**Date:** Staked 12/16/13 drawn on 12/23/13.

**Re:** Staked by Elijah Frane  
**Drawn:** Drawn by Dustin Cotter

**Basis of Elevation Spot:** USGS BM = E 25, PID = KJ0219, H-Order = First, V-Order = First, Stability = C, P-DOP = 1.90, Sats = 8 US NAD 83 CO-C, Lat. = 39.21461, Long. = W103.60209 = 5248.17 gr. (us FT)

**Notes:** See Location Drawing for improvements within 500' of proposed well pad.  
 The ground elevation at staked location = 5273.92' gr.  
 This drawing does not represent a monumented survey or Land Survey Plat.

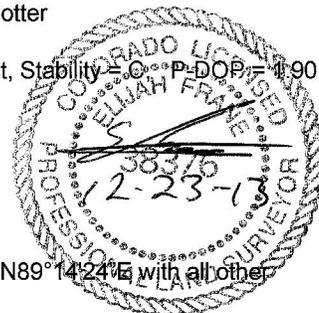

**Basis of Bearing:** Bearings were determined based on the North line of Section 24 to bear N89°14'24"E with all other bearings contained herein relative thereto.

