




Lat40°, Inc. 1635 Foxtrail Drive, Suite 325 Loveland, CO 970-776-3321

ACCESS ROAD MAP

NCLP AA06-67-1HNC PAD &
NCLP PC AA04-66-1HN PAD

SECTION: 4
TOWNSHIP: 6N
RANGE: 63W

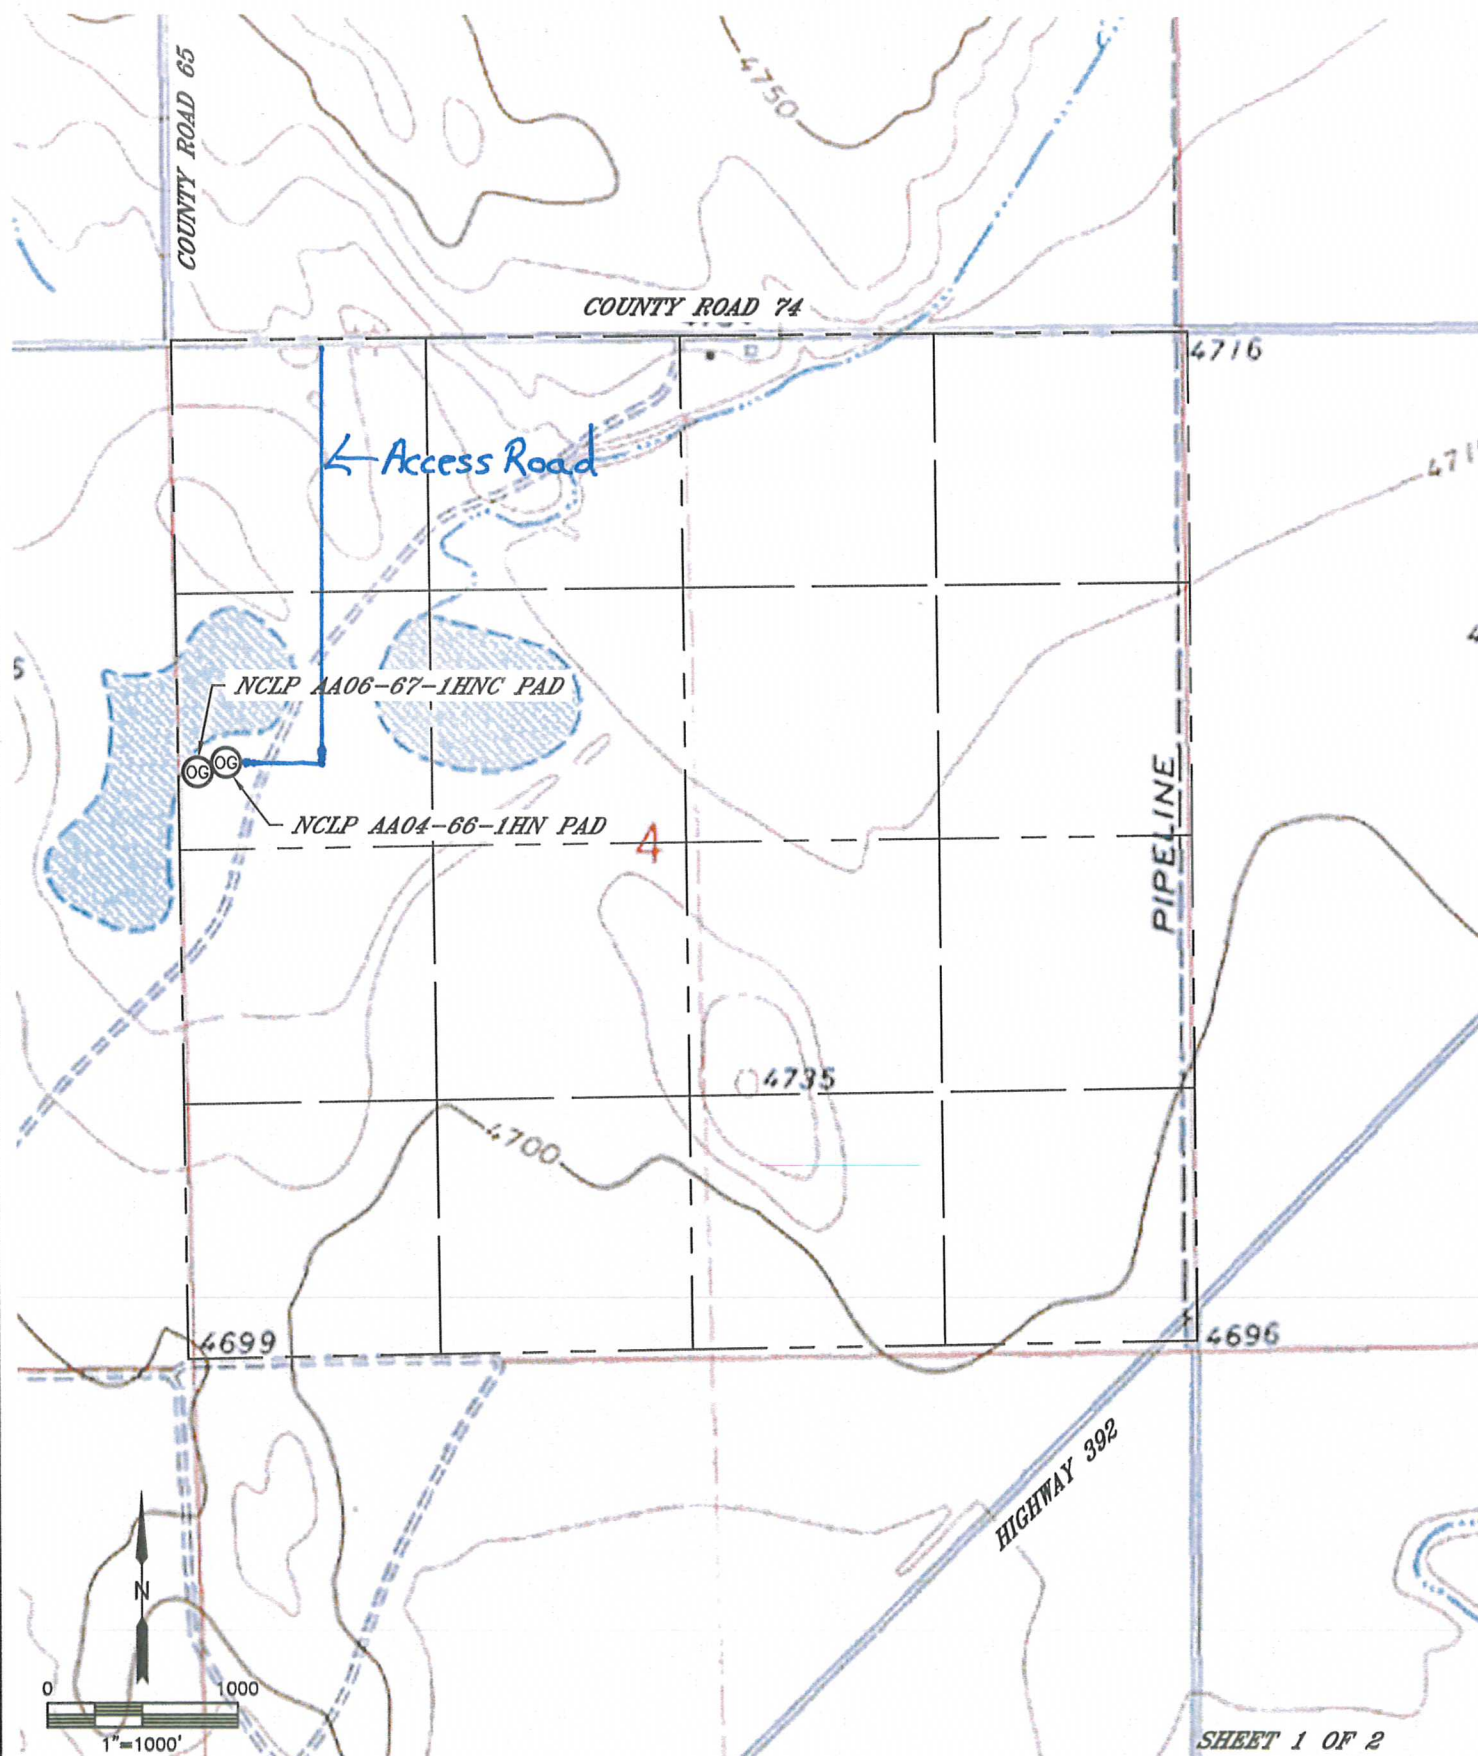

SHEET 1 OF 2

DATE: 10/31/2013
PROJECT#: 2013042




Lat40°, Inc. 1635 Foxtrail Drive, Suite 325 Loveland, CO 970-776-3321

ACCESS ROAD MAP

NCLP AA06-67-1HNC PAD &
NCLP PC AA04-66-1HN PAD

SECTION: 4
TOWNSHIP: 6N
RANGE: 63W

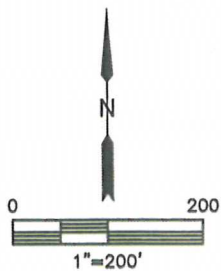

SHEET 2 OF 2

DATE: 10/31/2013
PROJECT#: 2013042