


KERR-MCGEE OIL AND GAS ONSHORE LP
ROCKY MTN COORS GU 2
SW NW 1 2N 68W -- --
WELD,COLORADO
01/15/2014

AREA: S1 ROUTE: S13 Spud: 06/01/1980 WINS No.: 74340 AFE/WO#: 2090555 API#: 0512309941

GL: 4825 KB: 4838 MTD: 7890 TVD: 7890 LOG MD: 7868 PBMD: 7832 PBTVD: 7832

Directions: WCR 11-1/4 & WCR 24-3/4, SW 1/10 INTO

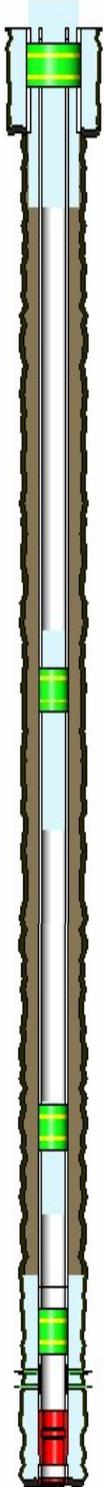

<u>HOLE SECTIONS</u>	<u>Size</u>	<u>Top</u>	<u>Btm</u>	<u>TD Date</u>
SURFACE	12.25	13	395	06/01/1980
PRODUCTION	7.88	390	7890	06/09/1980

<u>TUBULARS</u>	<u>Tool Type</u>	<u>Joints</u>	<u>Size</u>	<u>Weight</u>	<u>Grade</u>	<u>Thread</u>	<u>Top D</u>	<u>Bottom D</u>
SURFACE CASING	Casing	9	8.63	24.00	J-55	ST&C	13	390
PRODUCTION CASING	Casing	2	4.50	11.60	K-55	LT&C	13	73
	Casing	182	4.50	10.50	K-55	LT&C	73	7532
	Casing	6	4.50	11.60	K-55	LT&C	7532	7832
	Casing Float Collar	1	4.50				7832	7834
	Casing	1	4.50	11.60	K-55	LT&C	7834	7889
	Casing Guide Shoe	1	4.50				7889	7890
CAST IRON CEMENT RETAINER	Cement Retainer	1	4.50				6610	6611
BRIDGE PLUG	CIBP With CMT Cap	1	4.50				7682	7683
CAST IRON CEMENT RETAINER	Cement Retainer	1	4.50				3975	3976
BRIDGE PLUG	Cast Iron Bridge Plu	1	8.63				95	97

<u>CEMENT JOBS</u>	<u>Stage</u>	<u>Sacks</u>	<u>Cement Jobs</u>	<u>Top D</u>	<u>Btm D</u>	<u>cbf</u>
SURFACE CASING	STAGE 1	350	REGULAR	13	390	No
PRODUCTION CASING	STAGE 1	200	50/50 POZ-MIX	7453	7890	No
PRODUCTION CASING	ABANDONMENT PLUC			6580	7040	No
PRODUCTION CASING	ABANDONMENT PLUC			3730	4770	No
SURFACE CASING	ABANDONMENT PLUC			450	890	No
SURFACE CASING	ABANDONMENT PLUC			0	450	No

<u>PERFORATIONS</u>						
<u>Formation</u>	<u>Zone</u>	<u>Top</u>	<u>Btm</u>	<u>Date</u>	<u>Reason</u>	<u>Comments</u>
J SAND		7040	7041	11/21/2013	CEMENT SQUEEZE	
J SAND		7742	7770	11/06/1980	PRODUCTION	4 SPF

Comments: