


KERR-MCGEE OIL AND GAS ONSHORE LP
DOLPH UPRR 32-1
SW NE 1 2N 66W 1,980' FNL 1,814' FEL
WELD,COLORADO
01/16/2014

AREA: S4 ROUTE: S45 Spud: 10/15/1992 WINS No.: 75185 AFE/WO#: 00085327 API#: 0512316165

GL: 5032 KB: 5043 MTD: 7628 TVD: 7628 LOG MD: 7640 PBMD: 7587 PBTVD: 7587

Directions: WCR 22 AND WCR 37, NORTH 1-6/10 MILE, WEST INTO LOCATION.

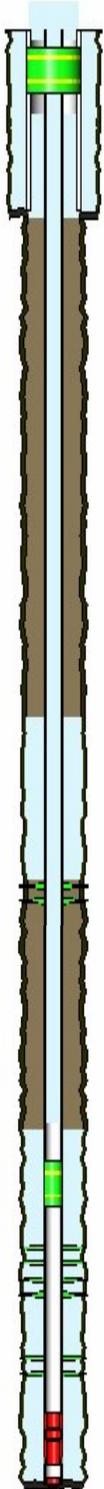

<u>HOLE SECTIONS</u>		<u>Size</u>	<u>Top</u>	<u>Btm</u>	<u>TD Date</u>				
SURFACE		12.25	11	908	10/16/1992				
PRODUCTION		7.88	908	7628	10/20/1992				
<u>TUBULARS</u>		<u>Tool Type</u>	<u>Joints</u>	<u>Size</u>	<u>Weight</u>	<u>Grade</u>	<u>Thread</u>	<u>Top D</u>	<u>Bottom D</u>
SURFACE CASING		Casing	20	8.63	24			11	882
PRODUCTION CASING		Casing	242	2.88	6.5	N-80	8RD EUE	11	7587
		Casing Float Collar	1	2.88				7587	7588
		Casing	1	2.88	6.5	N-80	8RD EUE	7588	7620
		Casing Guide Shoe	1	2.88				7620	7621
BRIDGE PLUG		Cast Iron Bridge Plu	1	2.88				7000	7001
BRIDGE PLUG		Cast Iron Bridge Plu	1	8.63				95	97
<u>CEMENT JOBS</u>		<u>Stage</u>	<u>Sacks</u>	<u>Cement Jobs</u>		<u>Top D</u>	<u>Btm D</u>	<u>cbl</u>	
SURFACE CASING		STAGE 1	260	LEAD	LITE	11	600	No	
		STAGE 1	150	TAIL	REGULAR	600	882	No	
PRODUCTION CASING		STAGE 1	230	LEAD	G	6790	7621	Yes	
PRODUCTION CASING		ABANDONMENT PLUC				0	6750	No	
PRODUCTION CASING		ABANDONMENT PLUC	710	LEAD	FRESH WATER	4240	5320	No	
PRODUCTION CASING		ABANDONMENT PLUC	73	LEAD	FRESH WATER	940	1000	No	
SURFACE CASING		ABANDONMENT PLUC				240	930	No	
SURFACE CASING		ABANDONMENT PLUC				0	64	No	
<u>PERFORATIONS</u>		<u>Formation</u>	<u>Zone</u>	<u>Top</u>	<u>Btm</u>	<u>Date</u>	<u>Reason</u>	<u>Comments</u>	
SUSSEX				5320	5322	12/12/2013	CEMENT SQUEEZE		
				6750	6751	12/10/2013	CEMENT SQUEEZE		
NIOBRARA		A		7173	7189	03/22/2000	PRODUCTION	7173', 7186', 7189' - 4SPF	
NIOBRARA		B		7200	7215	03/22/2000	PRODUCTION		
CODELL				7443	7453	11/04/1992	PRODUCTION		
CODELL				7443	7453	08/13/2001	PRODUCTION		

Comments: