



Physical Address: 345 Comanche St.
 Mail to: Box 384, Kiowa, CO 80117
 Ph. 303-621-8672 - Fax 303-621-7749
 www.highprairiesurvey.com

Job # 11094 Ma-State #7

Inv # 2881


High Prairie Surveying of Kiowa, Colorado has in accordance with a request from **Wiepking Fullerton** has determined the location of **Ma-State #7** to be **746 feet FNL**, and **744 feet FWL**, (90° off Section lines) of SECTION **24**, Township **10s**, Range **56w** of the 6th Principal Meridian, **Lincoln County**, Colorado.

Date: Staked 12/16/13 drawn on 12/23/13.

Re: Staked by Elijah Frane
Drawn: Drawn by Dustin Cotter

Basis of Elevation Spot: USGS BM = E 25, PID = KJ0219, H-Order = First, V-Order = First, Stability = C, P-DOP = 1.90, Sats = 8 US NAD 83 CO-C, Lat. = 39.21461, Long. = W103.60209 = 5248.17 gr. (us FT)

Notes: See Location Drawing for improvements within 500' of proposed well pad.
 The ground elevation at staked location = 5319.61' gr.
 This drawing does not represent a monumented survey or Land Survey Plat.

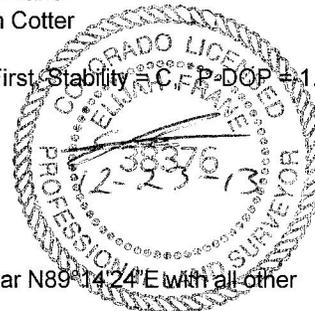

Basis of Bearing: Bearings were determined based on the North line of Section 24 to bear N89°14'24"E with all other bearings contained herein relative thereto.

