



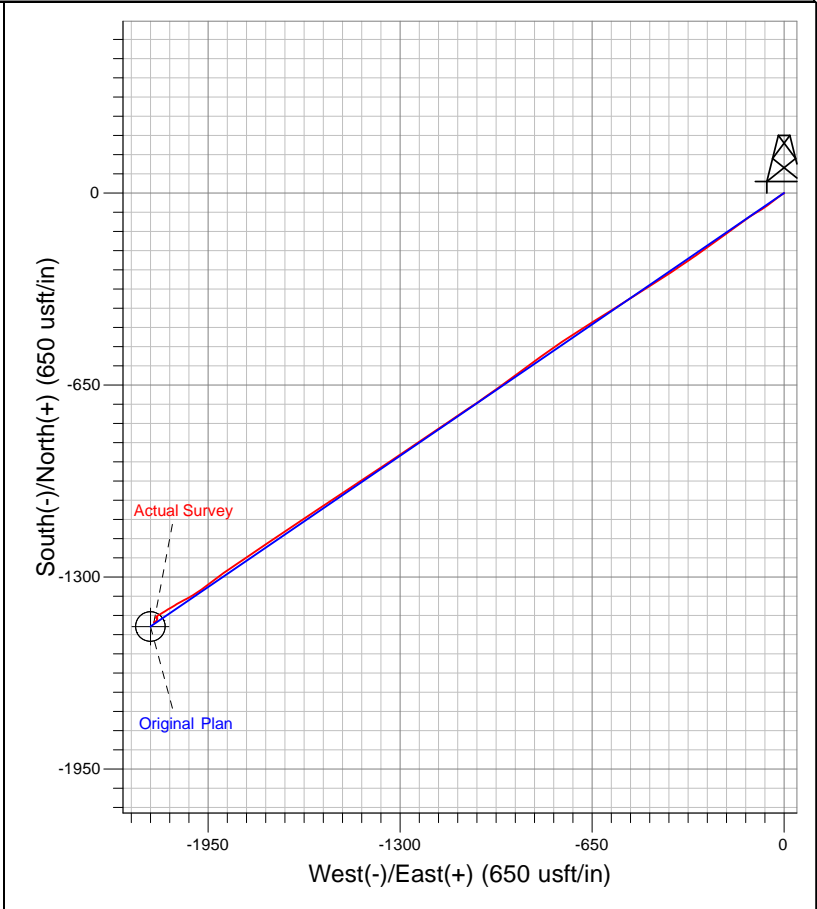

Well Name: RU 313-5
Surface Location: Single Cellar RU 23-5 Pad
North American Datum 1983 , US State Plane 1983 . Colorado Central Zone
Ground Elevation: 7602.00
+N/-S +E/-W Northing Easting Latitude Longitude Slot
0.00 0.00 1605995.50 2351156.40 39.47469 -107.79878 A19
KELLY BUSHING @ 7628.00usft

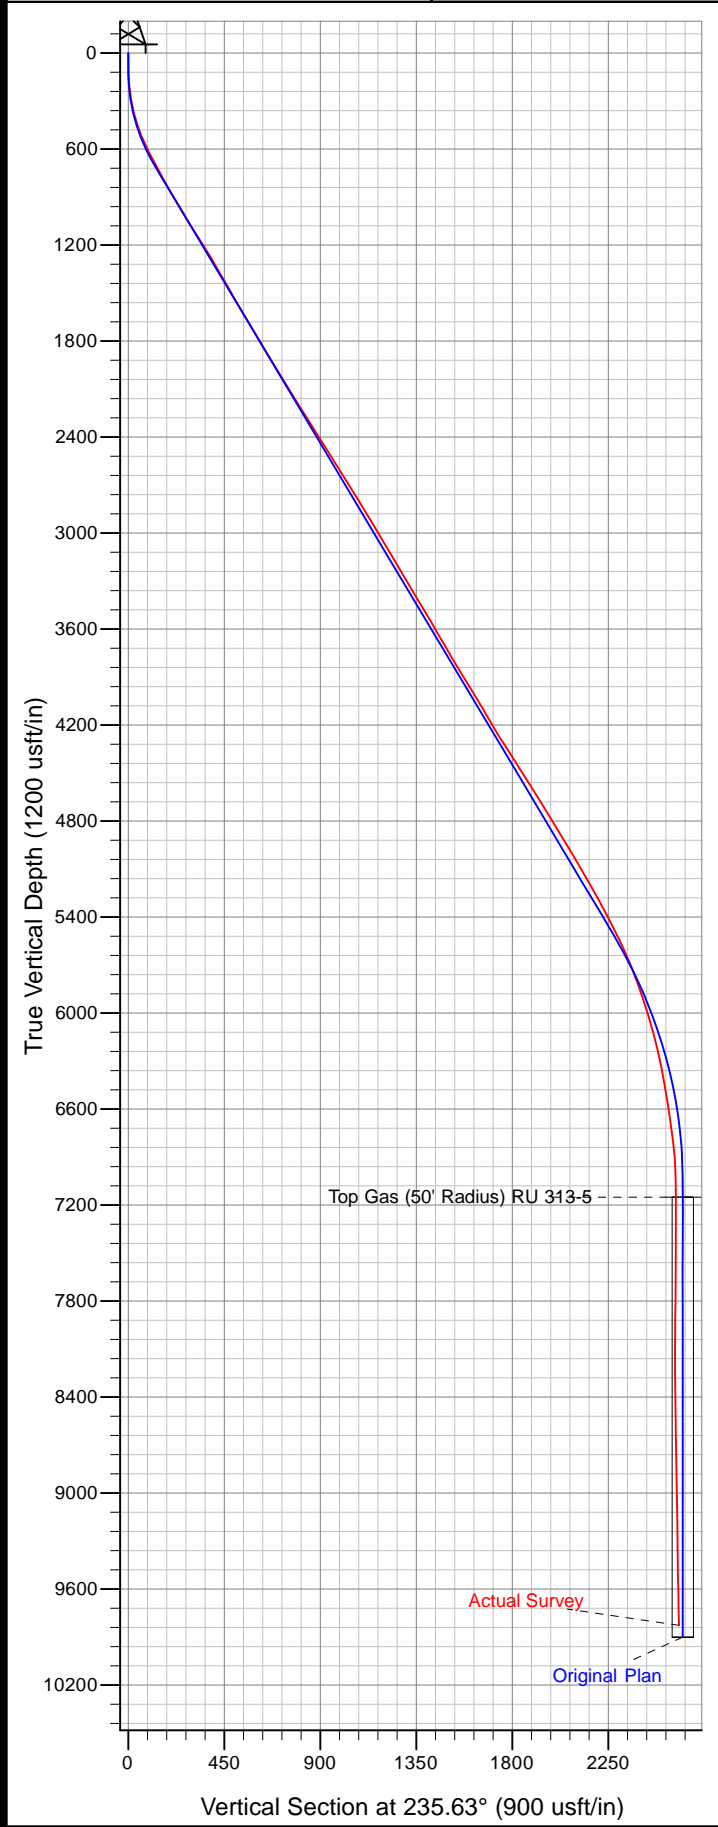

Azimuths to True North
Magnetic North: 9.96°
Magnetic Field
Strength: 52018.5snT
Dip Angle: 65.69°
Date: 10/3/2013
Model: IGRF2010