




Lat40°, Inc. 1635 Foxtrail Drive, Suite 325 Loveland, CO 970-776-3321

RECLAMATION DRAWING

ANSCHUTZ EQUUS FARMS-04-62-09 PAD
(3 OF 3)

SECTION: 9
TOWNSHIP: 4N
RANGE: 62W

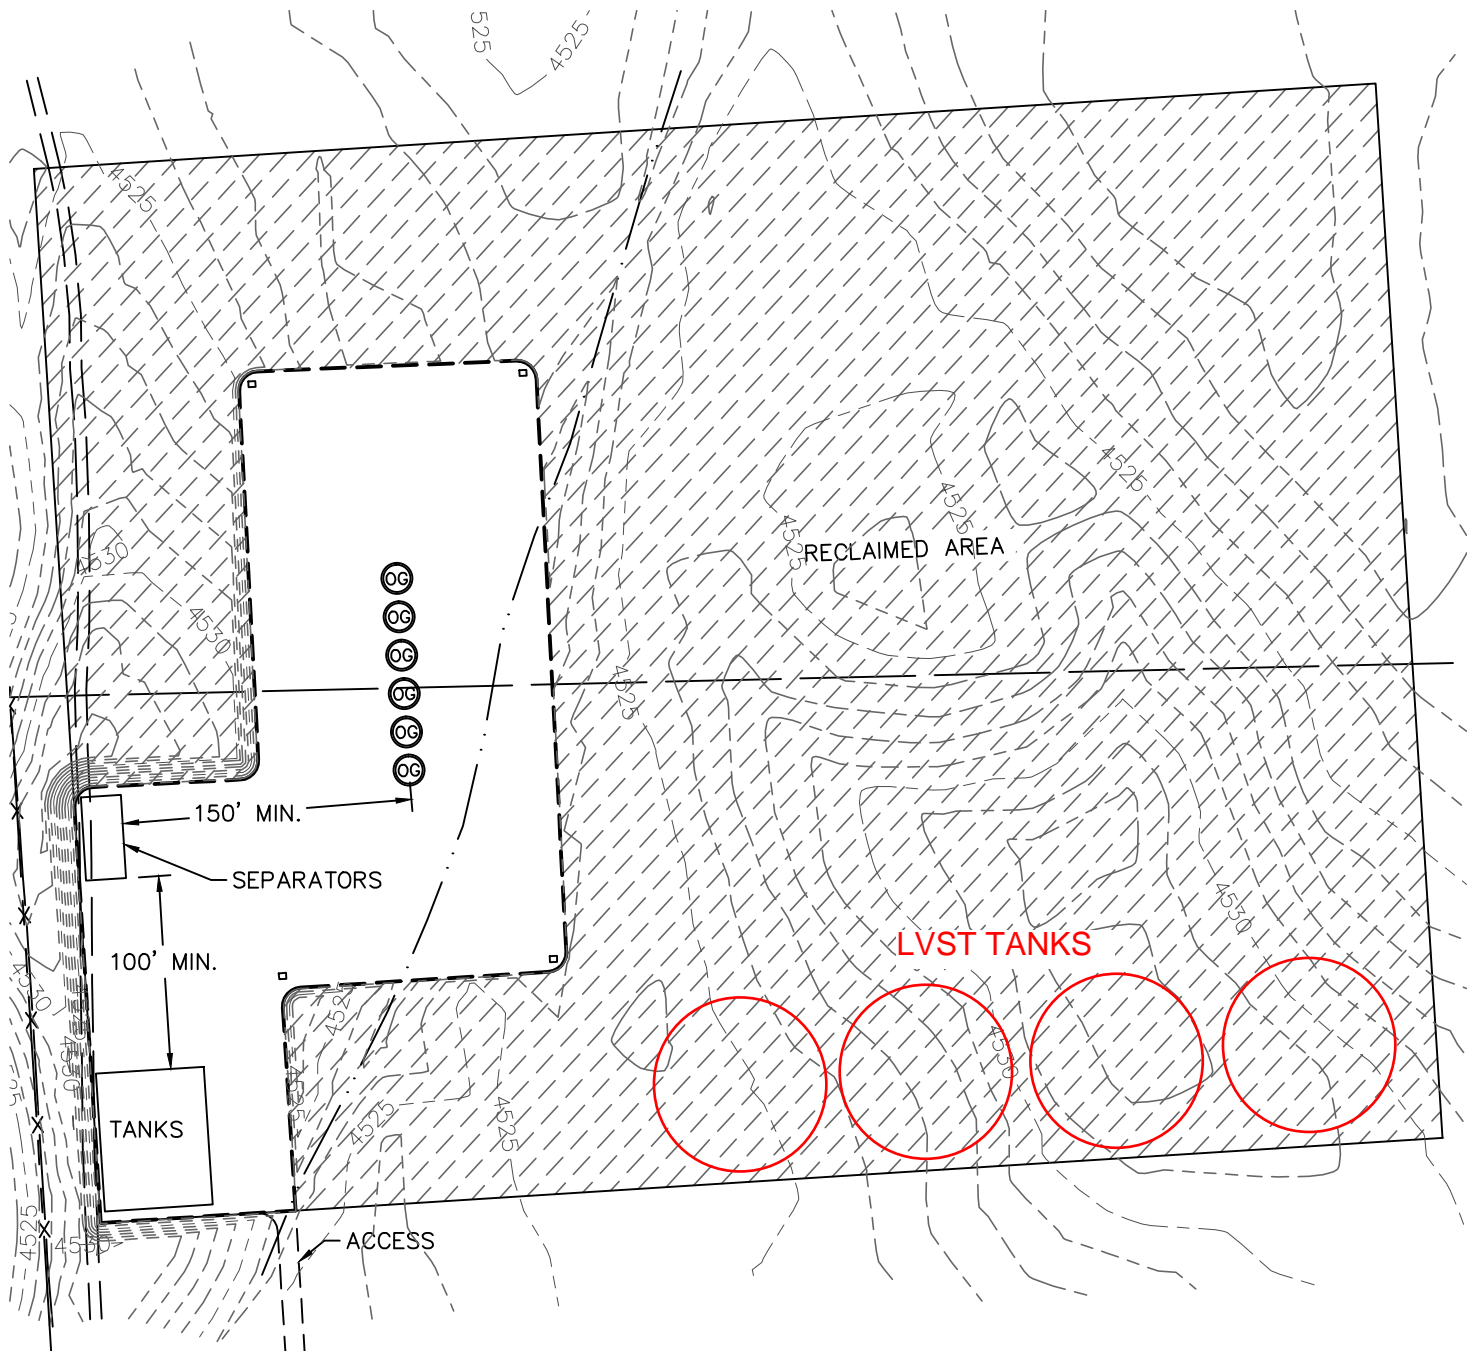

UNRECLAIMED AREA: 1.8 ACRES

DATE: 3/28/2013
PROJECT#: 2013006