


NOBLE ENERGY INC  
SHAHER USX W 35-7  
---- Section ----  
WELD,COLORADO  
02/06/2014

AREA: E3      ROUTE: E34    Spud: 06/08/1983    WINS No.: 10329    AFE/WO#: 88446290    API#: 0512311215

GL: 5096    KB: 5111    MTD: 8180    TVD: 8180    LOG MD:    PBMD: 8127    PBTVD:

Directions: CR 14 & CR 37, W 1 5/10, N 6/10, E 1/10 INTO.

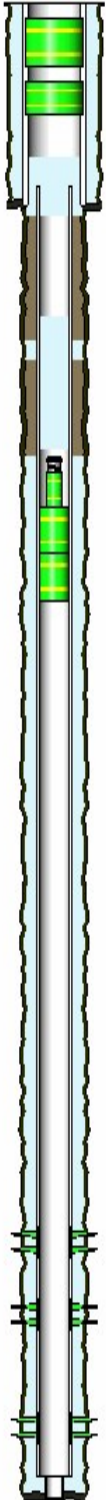

<u>HOLE SECTIONS</u>		<u>Size</u>	<u>Top</u>	<u>Btm</u>	<u>TD Date</u>
SURFACE		12.25	15	1130	06/08/1983
PRODUCTION		7.88	1130	8180	06/14/1983

<u>TUBULARS</u>	<u>Tool Type</u>	<u>Joints</u>	<u>Size</u>	<u>Weight</u>	<u>Grade</u>	<u>Thread</u>	<u>Top D</u>	<u>Bottom D</u>
SURFACE CASING								
	Casing	28	9.63	36.00	J-55		15	1123
BRIDGE PLUG								
	Tubing	1	2.38		J-55		3939	3959
	XN Profile Nipple	1	2.38				3959	3961
	Retrieving Head	1	4.50				3961	3963
	Retrievable Bridge F	1	4.50				3963	3967
PRODUCTION CASING								
	Casing	182	5.50	14.00	J-55		920	8177
	Casing	1					8177	8178
BRIDGE PLUG								
	Cast Iron Bridge Plu	1	8.63				115	117
BRIDGE PLUG								
	Cast Iron Bridge Plu	1	8.92				96	98

<u>CEMENT JOBS</u>	<u>Stage</u>	<u>Sacks</u>	<u>Cement Jobs</u>		<u>Top D</u>	<u>Btm D</u>	<u>cbl</u>
SURFACE CASING							
	PRIM CMT 1ST STAGE	550	LEAD	FRESH WATER	15	1123	No
SURFACE CASING							
	PRIM CMT 1ST STAGE	1200	LEAD	FRESH WATER	3924	8178	No
PRODUCTION CASING							
	ONE INCH JOB	60	LEAD	FRESH WATER	2620	2840	Yes
PRODUCTION CASING							
	ABANDONMENT PLUC				2371	3842	No
SURFACE CASING							
	ABANDONMENT PLUC	125	LEAD-1	FRESH WATER	578	1238	No

<u>PERFORATIONS</u>		<u>Top</u>	<u>Btm</u>	<u>Date</u>	<u>Reason</u>	<u>Comments</u>
<u>Formation</u>	<u>Zone</u>	2805	2806	01/27/2005	CEMENT SQUEEZE	
NIOBRARA		7326	7352	07/17/2006	PRODUCTION	
CODELL		7570	7584	02/02/2005	PRODUCTION	
J SAND		8002	8024	06/20/1983	PRODUCTION	

Comments: