

Physical Address: 345 Comanche St.
 Mail to: Box 384, Kiowa, CO 80117
 Ph. 303-621-8672 - Fax 303-621-7749
 www.highprairiesurvey.com

Job: 08246 Aloha Mula #16

Inv # 2890


High Prairie Surveying of Kiowa, Colorado has in accordance with a request from **Wiepking Fullerton Energy** has determined the location of **Aloha Mula #16** to be **1980 feet FNL**, and **660 feet FWL**, (90° off Section lines) of SECTION 19, Township 10s, Range 55w of the 6th Principal Meridian, **Lincoln County**, Colorado.

Date: Staked on 12/16/13 drawn on 12/24/13.

Re: Staked by Elijah Frane

Drawn: Drawn by Dustin Cotter

Basis of Elevation Spot: USGS BM = E 25, PID = KJ0219, H-Order = First, V-Order = First, Stability = 0.0, P-DOP = 1.8
 Sats = 9, US NAD 83 CO-C, Lat. = 39.21461, Long. = W103.60209, Elevation = 5248.17 gr. (us)

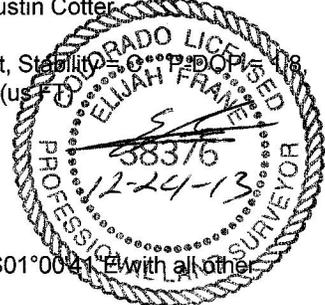

Notes: There are no apparent improvements within 500 ft. of proposed well pad.
 The ground elevation at staked location = 5286.13' gr.
 This drawing does not represent a monumented survey or Land Survey Plat.

Basis of Bearing: Bearings were determined based on the East line of Section 19 to bear S01°00'41"E with all other bearings contained herein relative thereto.

