



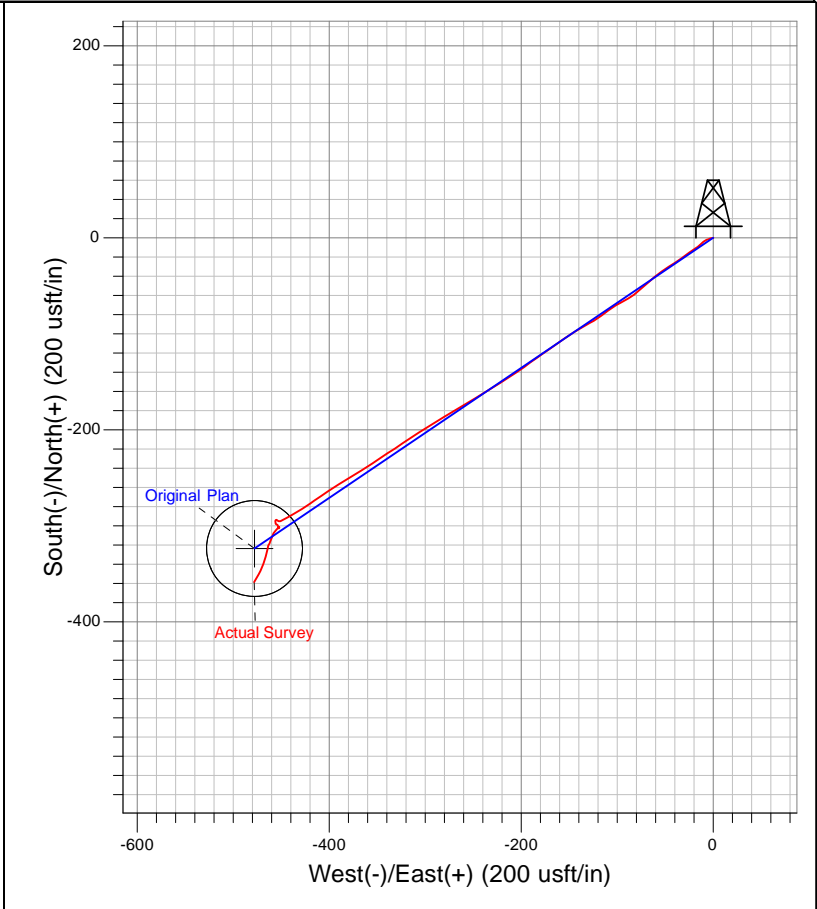

Well Name: RU 321-5
Surface Location: Single Cellar RU 23-5 Pad
North American Datum 1983 , US State Plane 1983 . Colorado Central Zone
Ground Elevation: 7602.00
+N/-S +E/-W Northing Easting Latitude Longitude Slot
0.00 0.00 1606002.70 2351154.40 39.47471 -107.79879 A18
KELLY BUSHING @ 7628.00usft

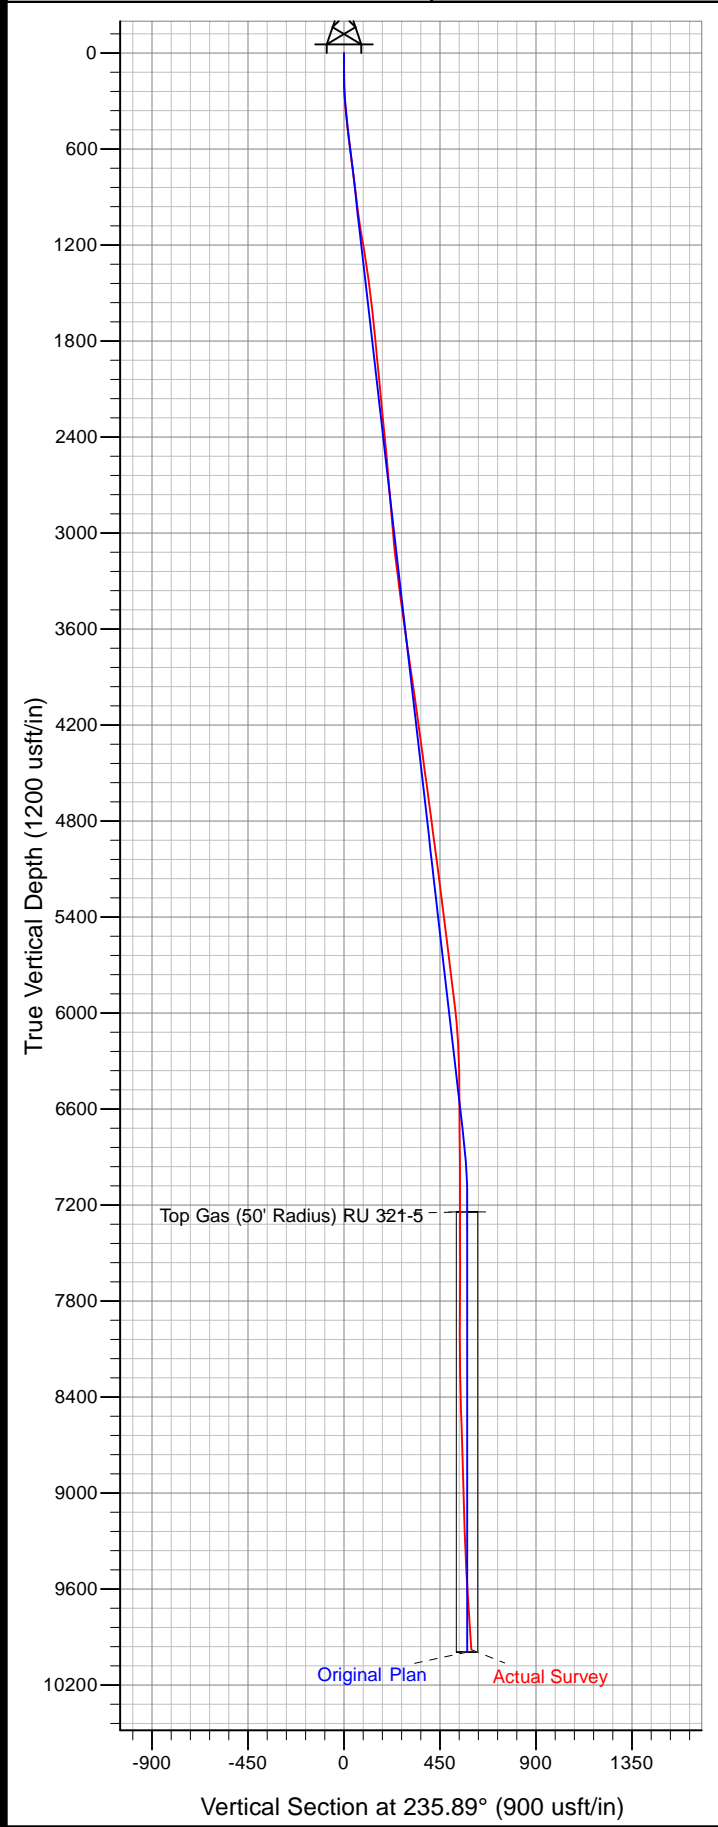

A compass rose diagram with a vertical arrow pointing up labeled 'T' for True North and a shorter arrow pointing slightly to the right labeled 'M' for Magnetic North.

Azimuths to True North
Magnetic North: 9.96°

Magnetic Field

Strength: 52013.8snT
Dip Angle: 65.69°
Date: 10/20/2013
Model: IGRF2010