


**WPX Energy Rocky Mountain LLC  
FEDERAL RU 341-5  
RULISON Field**

**SHL 233' FNL 2617' FWL (SE/4 NW/4) LOT 2 Section 5 T7S R93W 6th PM  
BHL 881' FNL 606' FEL (NE/4 SE/4) Section 5 T7S R93W 6th PM  
Garfield County Colorado**

**Formation Tops  
(Measured Depths)**

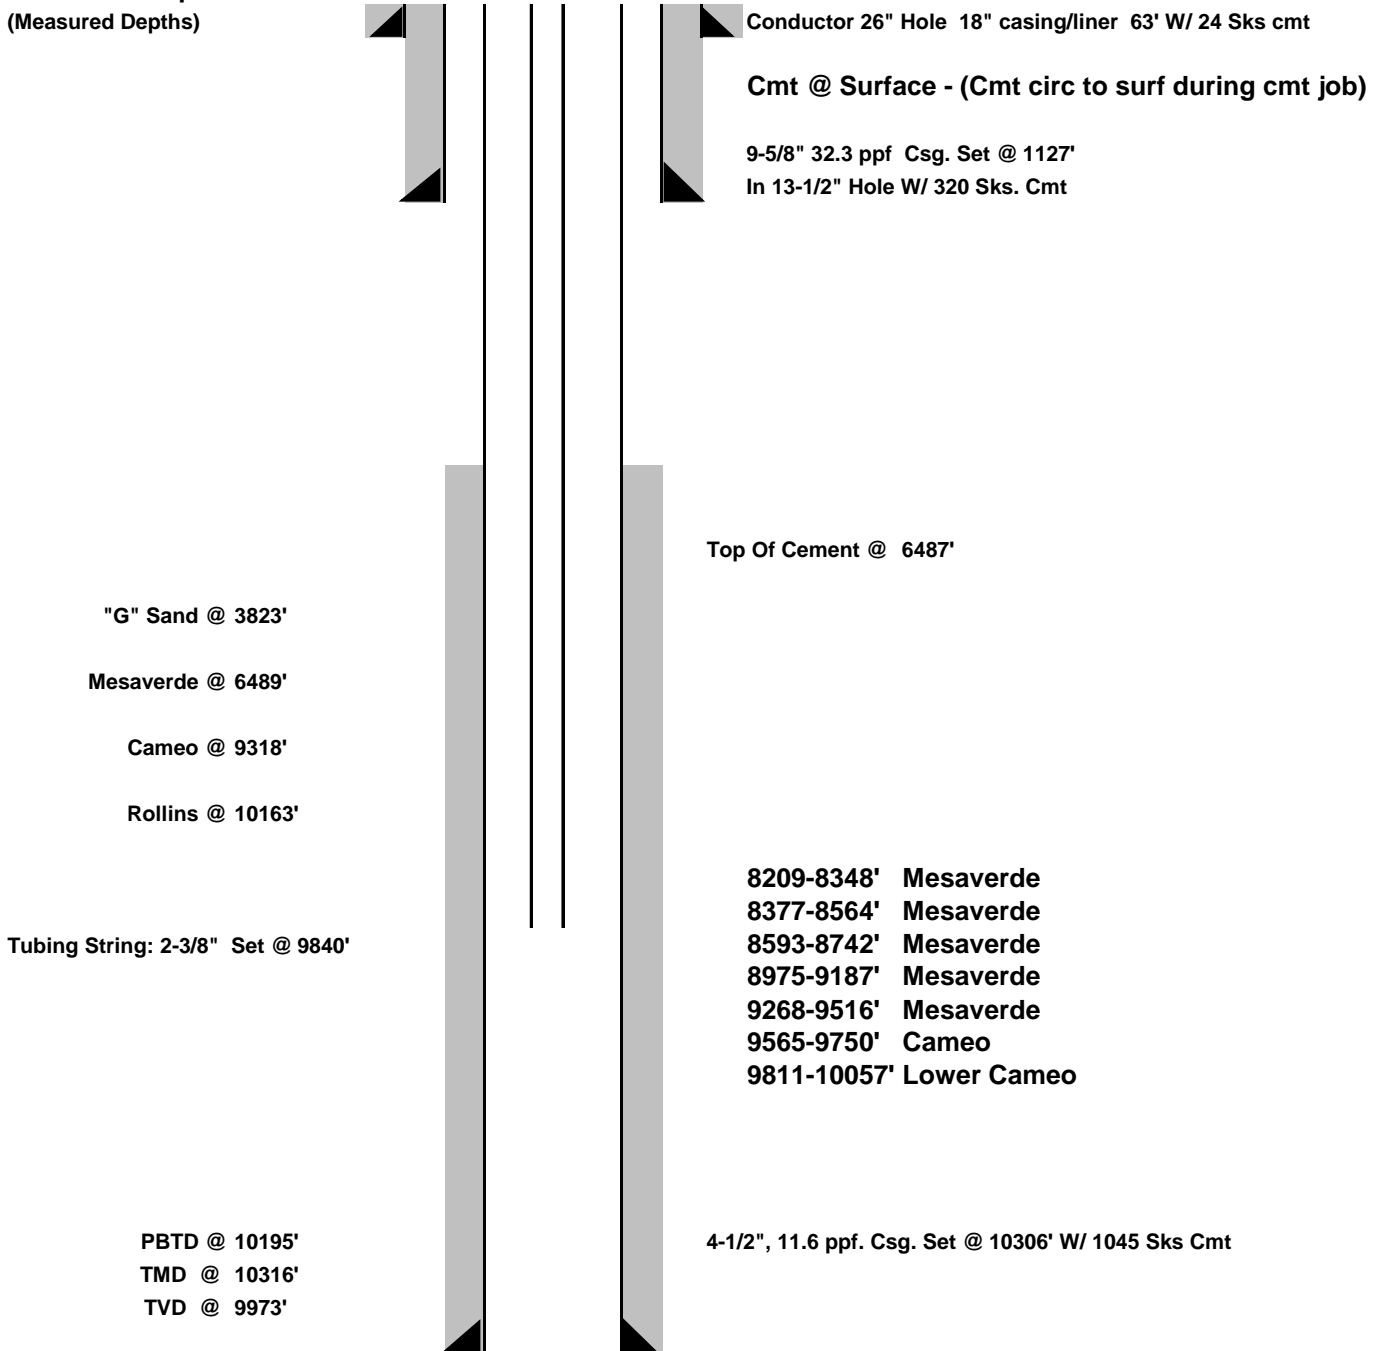

**DATE CREATED:** 2/4/2014

**NOTE: THIS IS NOT TO SCALE.  
\*\*FINAL\*\***