

La Posta 3R
La Plata County, Colorado
1/27/14 Sidetrack Completed Schematic

API: 05-067-07915
 Legals: Sec 5- T 33N - R 10W
 Field: Ignacio Blanco

Geologic Tops:
 Fruitland: 2525'

Spud: 11/30/92

GR Elev 6629'
 KB Elev 6645'

Surface CSG: 11/29/1992
 7 jts 9 5/8", 36# K55 set @ 330'
 CMT w/ 160 sxs cmt. Circ to bbls to surface

CSG: 12/4/1992
 61 jts, 7", 23#, J55, LT&C, 8rd. Set @ 2525'.
 CMT w/ 475 sxs cmt. Circ 25 sxs to surface.


Rods
 117 - 3/4" rods
 1 1/2" pump

Tubing
 88 jts 2-3/8" 4.7# L80 tubing
 Seating Nipple
 1 - 2 3/8" mud anchor
 EOT @ 2850' KB

Liner
 Liner Hanger @ 2351'
 5" 15# J55 casing
 5 5/8" bit
 Bottom @ 2876'

Perf'd Fruitland Coal Intervals

Top	Bottom	Feet
2644	- 2646	2
2742	- 2752	10
2798	- 2802	4
2865	- 2876	11

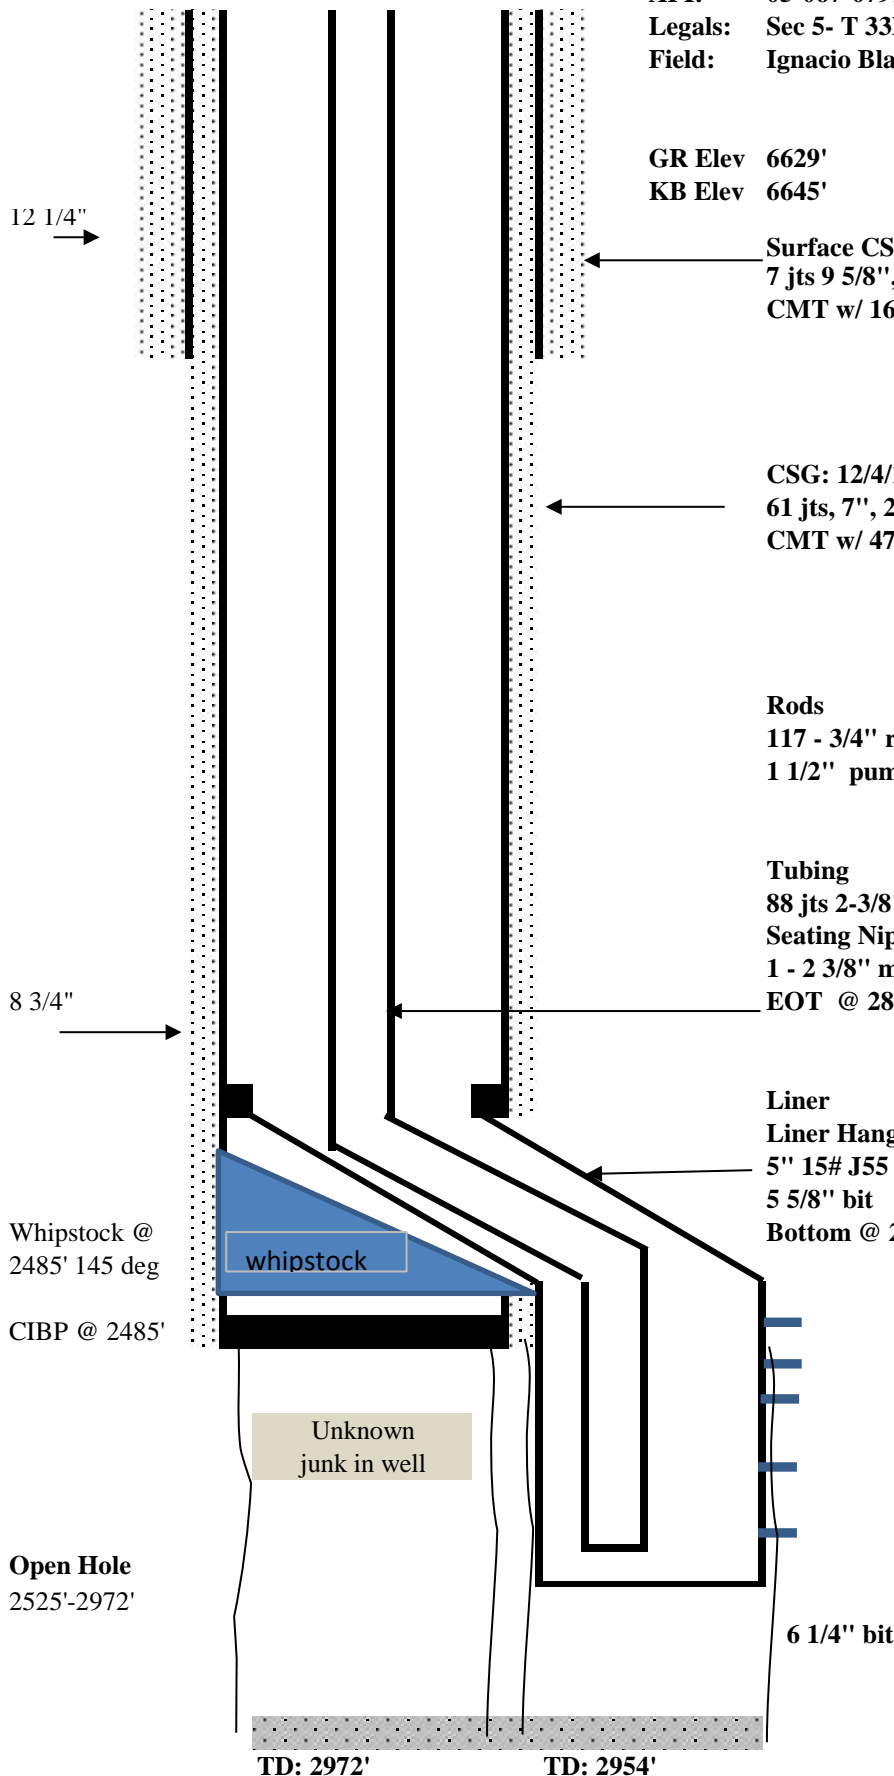

Perfs
8
40
16
44