



Physical Address: 345 Comanche St.
Mail to: Box 384, Kiowa, CO 80117
Ph. 303-621-8672 - Fax 303-621-7749
www.highprairiesurvey.com


Job # 14020-APC-RUNYAN #1-11

Inv # 2971

High Prairie Surveying of Kiowa, Colorado has in accordance with a request from **MULL DRILLING COMPANY** has determined the location of **APC-RUNYAN #1-11** to be **2581 feet FNL**, and **1537 feet FWL**, (90° off Section lines) of **SECTION 11**, Township **17s**, Range **45w** of the 6th Principal Meridian, **Kiowa County**, Colorado.

Date: Staked on 01/29/14 Drawn on 01/30/14.

Re: Staked by Elijah Frane
Drawn: Drawn by Dustin Cotter

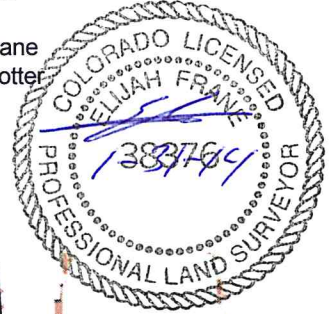

Location Drawing

There is a barb wire fence approximately 474' East of the proposed well pad at its closest point

MULL DRILLING COMPANY
NW1/4 SEC. 11-17S-45W
APC-RUNYAN #1-11
KIOWA, Co. COLORADO

