


KP KAUFFMAN

Townsend #1

NESE 5, T2N, R67W

Before P&A

05-123-10077

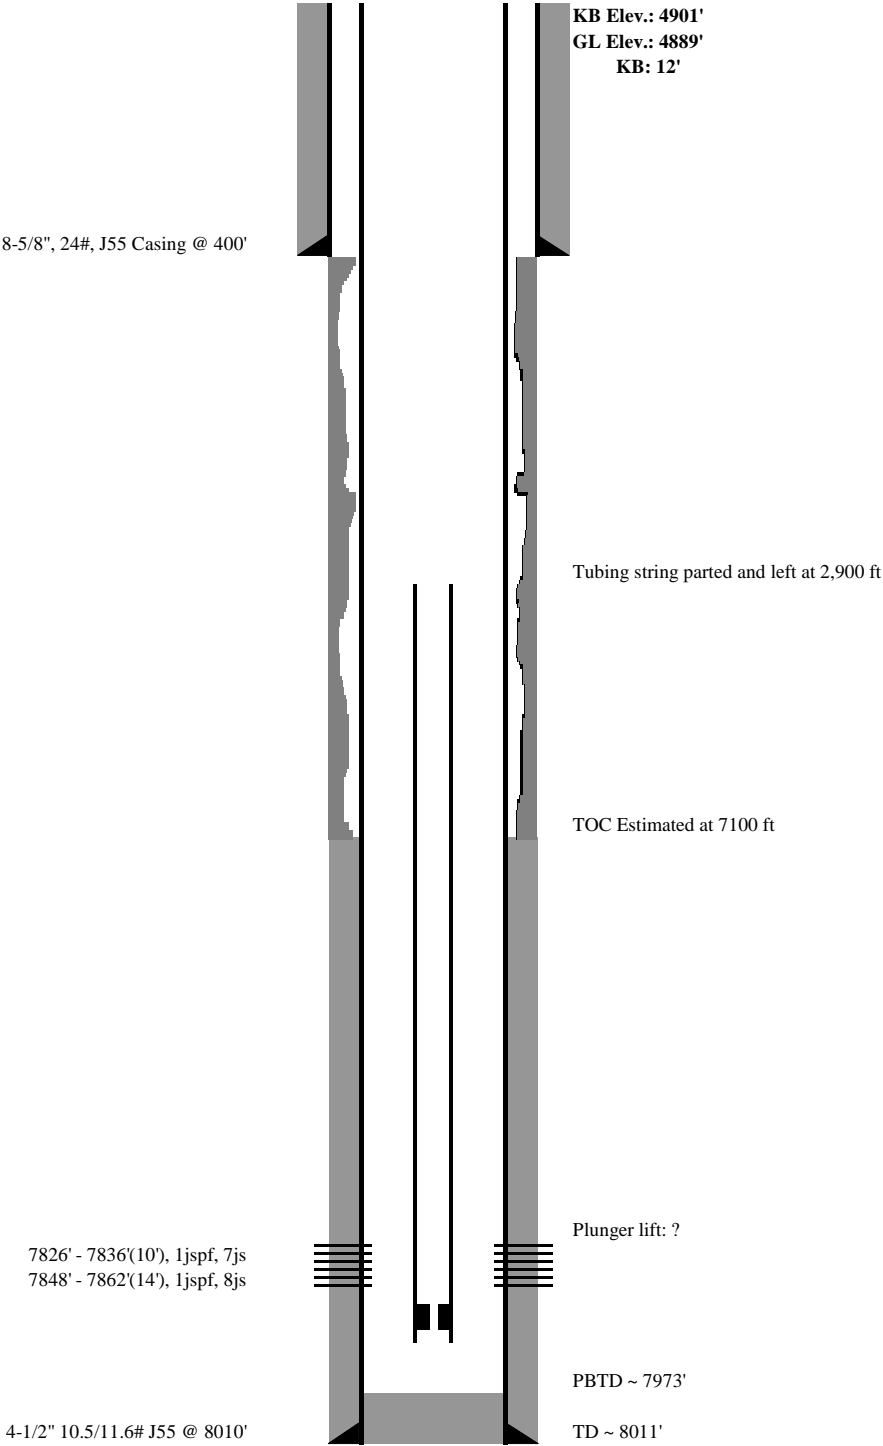

KP KAUFFMAN

Townsend #1

NESE 5, T2N, R67W

P&A

05-123-10077

