


# McPhearson #2

660' FNL1980 FEL NWNE 19 5N 61W 6th PM  
 Lat 40.391987 Long -104.249875 (from footages)  
 Weld County, Colorado  
 API #05-123-05180

Spud date 10/26/1956

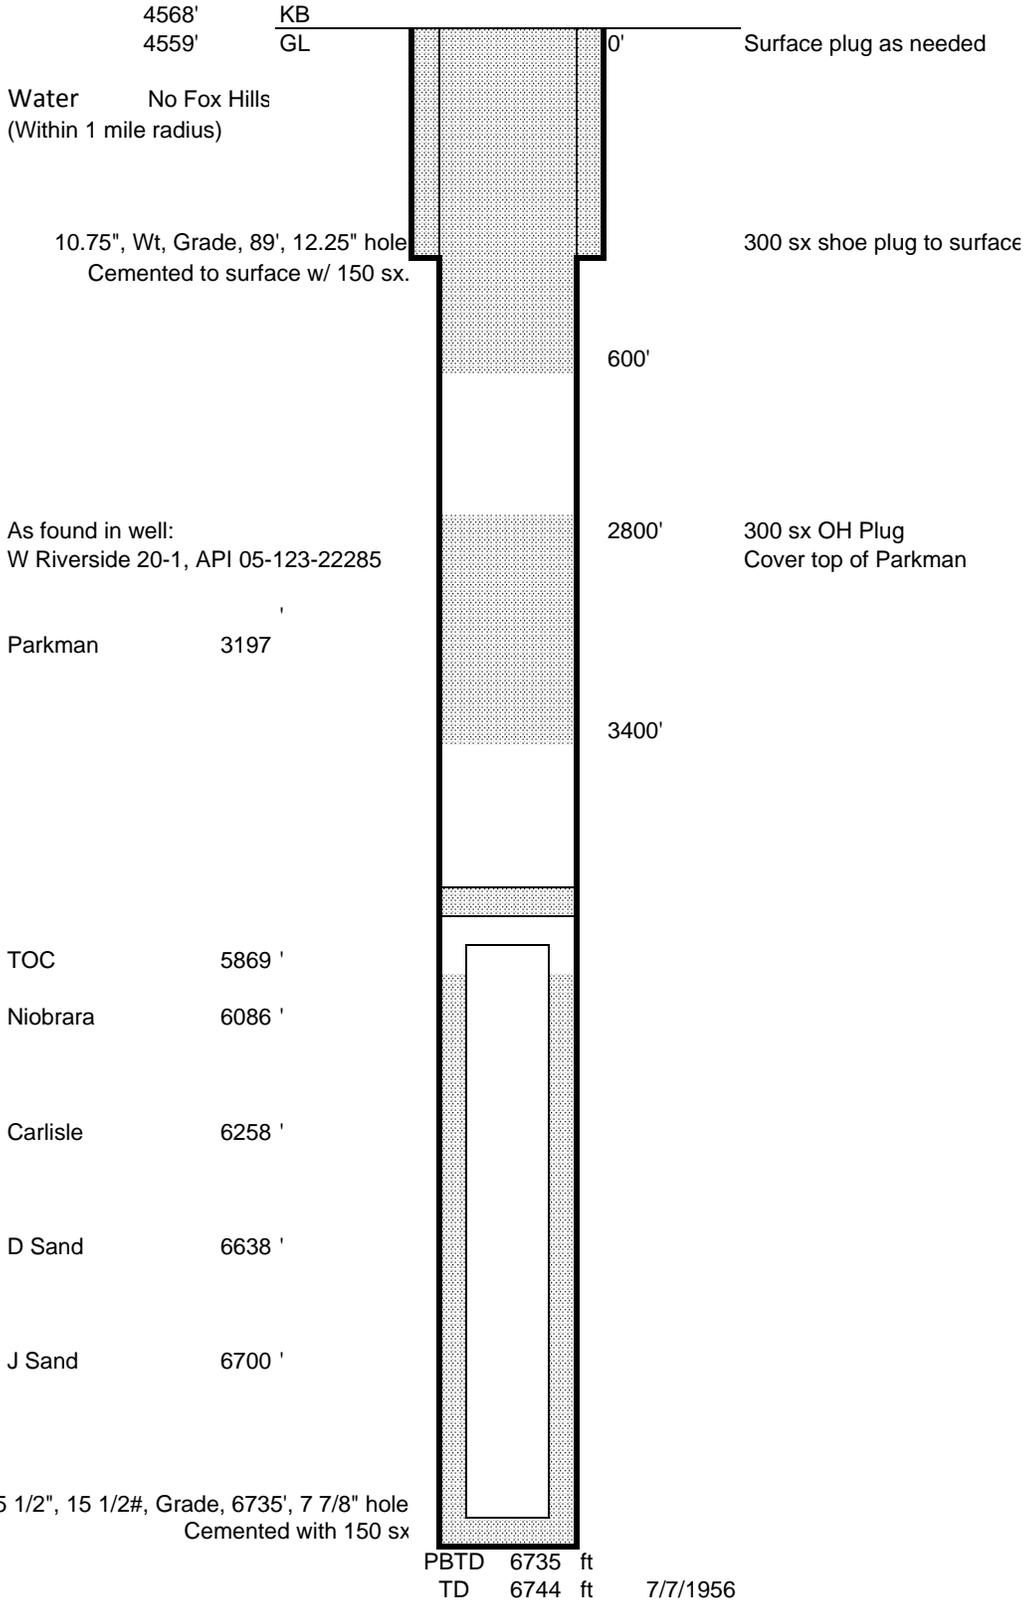

Updated 1/29/2014 srw