



Physical Address: 345 Comanche St.  
Mail to: Box 384, Kiowa, CO 80117  
Ph. 303-621-8672 - Fax 303-621-7749  
www.highprairiesurvey.com

Job # 14025 Hanavan #15-1 (Re-Entry)

Inv # 2979


High Prairie Surveying of Kiowa, Colorado has in accordance with a request from **Pronghorn Operating LLC** has determined the location of **Hanavan #15-1 (Re-Entry)** to be **671 feet FSL**, and **1984 feet FEL**, (90° off Section lines) of **SECTION 15**, Township **13s**, Range **44w** of the 6th Principal Meridian, **Cheyenne County**, Colorado.

**Date:** Staked on 02/10/2014 drawn on 02/11/2014

**Re:** Staked by Elijah Frane

**Drawn:** Drawn by Dustin Cotter

## Location Drawing

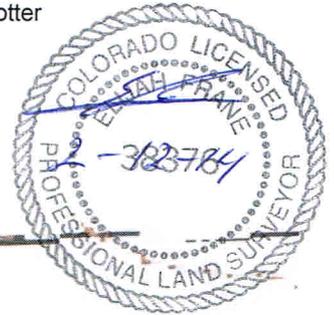

There are no apparent improvements within 500' of proposed well pad.

Pronghorn Operating LLC  
SE1/4 Sec. 15/13s/44w  
Hanavan #15-1 (Re-Entry)  
Cheyenne, Co. Colorado

