


Well Completion Diagram

API Well No: 05-071-08965			
Owner:	RED RIVER RANCH HOLDINGS LLC	Well Name:	RRR 13-6
County:	LAS ANIMAS	Field:	PURGATOIRE RIVER
Coordinates: X	Y	Sec: 7	Twp: 35S Rng: 68W

Note: Changes to the drawing do not effect the database

Bore Diameters (in.)

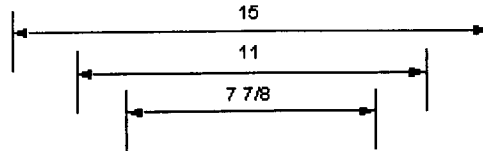

Cement Top: 0' mthd:U

Cement Top: 0' mthd:U

12-3/4" CONDUCTOR

Cement Top: 0' mthd:U

8 5/8" SURF

205'

50'-0' 5 sks

15 sks 155'-255'
CIBP 255'

2 sks cement
CIBP 654'

Perfs.

5 1/2" 1ST

Total Vertical Depth