



Physical Address: 345 Comanche St.  
 Mail to: Box 384, Kiowa, CO 80117  
 Ph. 303-621-8672 - Fax 303-621-7749  
 www.highprairiesurvey.com

Job # 13205 Blackcomb #6-14

Inv # 2603

High Prairie Surveying of Kiowa, Colorado, in accordance with a request from **Night Hawk Production LLC**, has determined the location of **BLACKCOMB #6-14** to be **1852 feet FNL**, and **2108 feet FWL**, (90° off Section lines) of **SECTION 14**, Township **6s**, Range **54w** of the 6th Principal Meridian, **Lincoln County**, Colorado.


Date: Staked on 08/06/13 drawn on 08/13/13.

**Re:** Staked by Elijah Frane

**Drawn:** Drawn by Dustin Cotter

**Basis of Elevation Spot:** USGS BM = TETLOW, PID = KJ0482, H-Order = Adjusted, V-Order = Scaled  
 Stability = Unknown, P-DOP = 2.6, Sats = 7 US NAD 83 CO-C 502, Lat. = 39.55762, Long. = W103.43345  
 Elevation = 5256.00 gr. (us FT).

**Notes:** See Location Drawing for improvements.  
 The ground elevation at staked location = 5176.75' gr.  
 This drawing does not represent a monumented survey or Land Survey Plat.

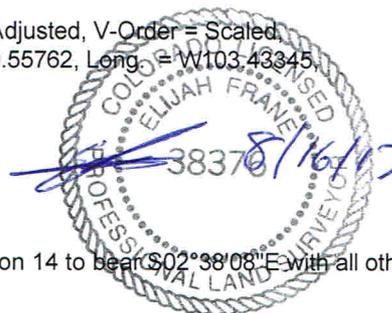

**Basis of Bearing:** Bearings were determined based on the West line of Section 14 to bear **S02°38'08"E** with all other bearings contained herein relative thereto.

