


WPX Energy Rocky Mountain LLC
 Federal RG 411-23-298
 API# 05-103-11900-00
 246' FSL X 1978' FWL (SESW) - SHL
 Sec. 14 - T2S-R98W, 6th PM
 914' FNL X 573' FWL (NWNW) - BHL
 Sec. 23-T2S-R98W, 6th PM
 Rio Blanco County, CO

FINAL

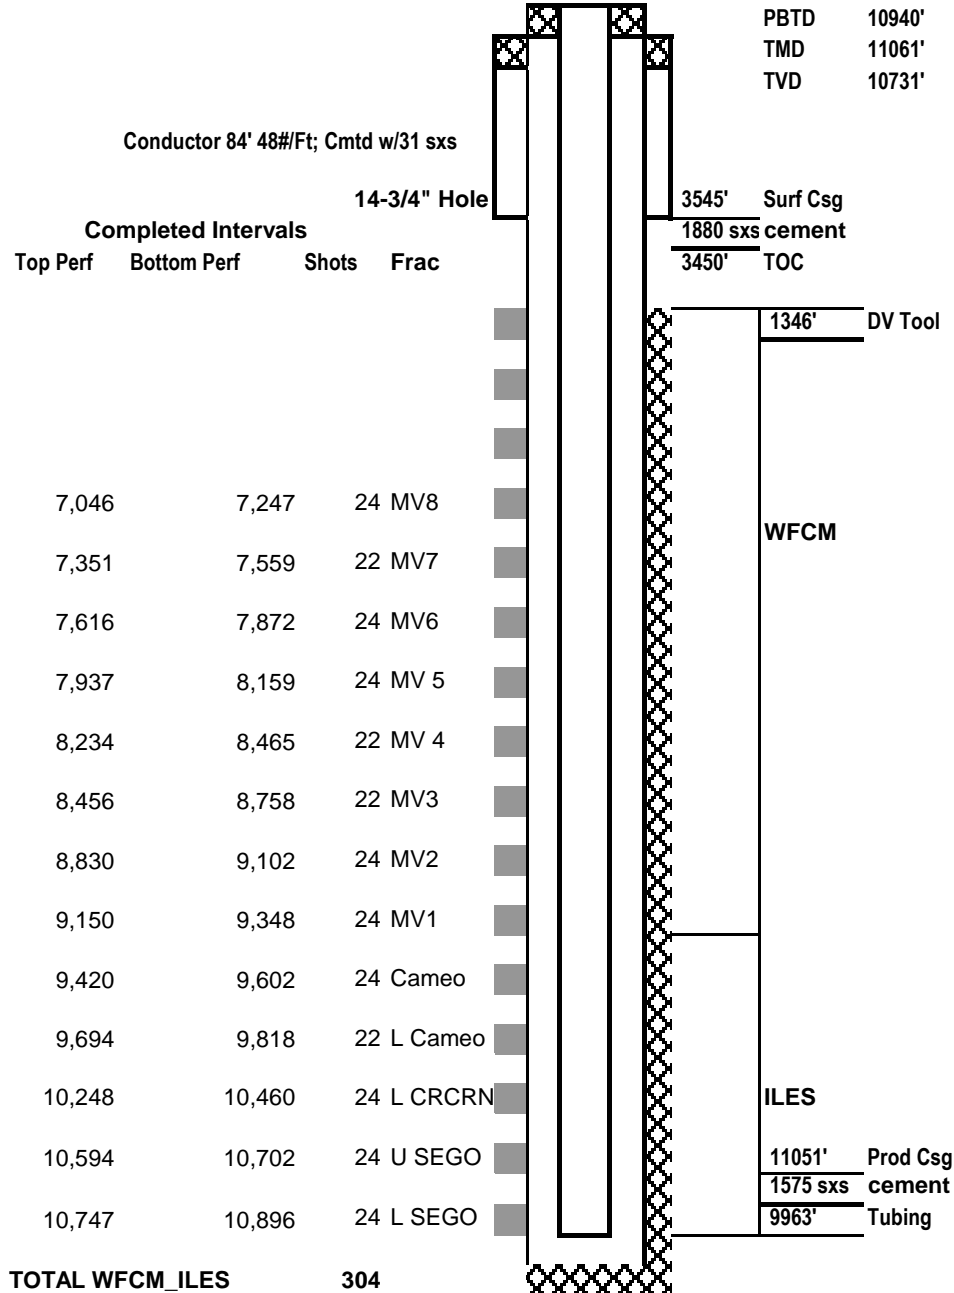

Created 2/17/2014

Note: This is not to scale