


Behring 23-10 / WB D AFTER ABANDONMENT.

API #: 05-123-22677

Surface Casing:


8 5/8" OD
24 lbs/ft
Depth - 3091'
220 sx of cement to surface
hole 12-1/4"

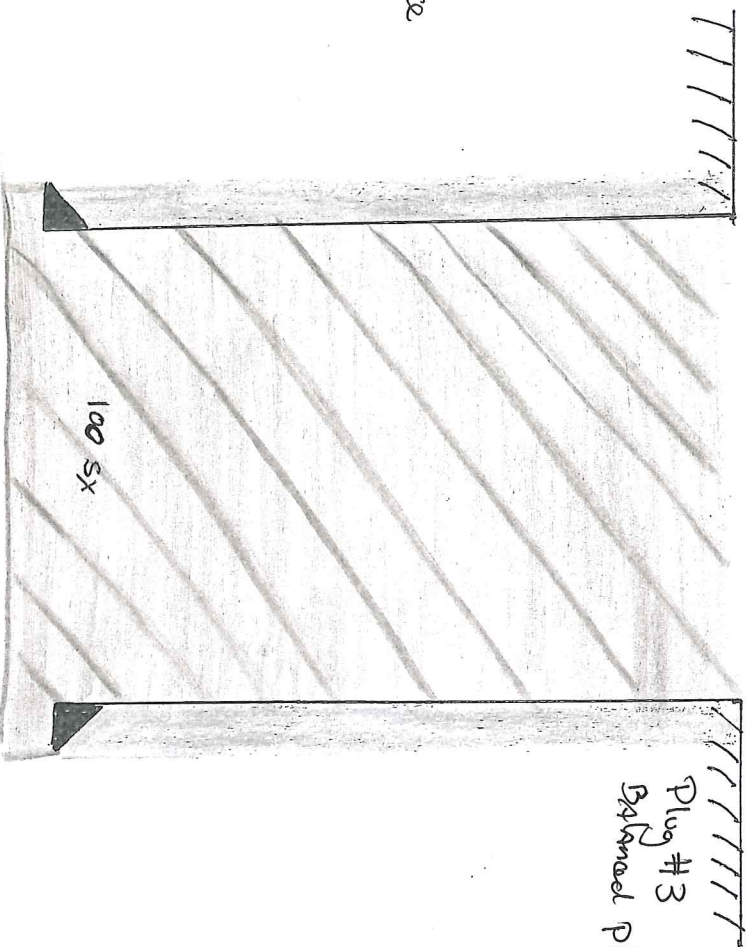

Plug #3
Balanced Plug: 3591'-Surface
100 sx or Visual
Return.

Plugged Back total Depth.
6,499'

fish: end of tubing
6,730'
Tubing anchor
6,540'

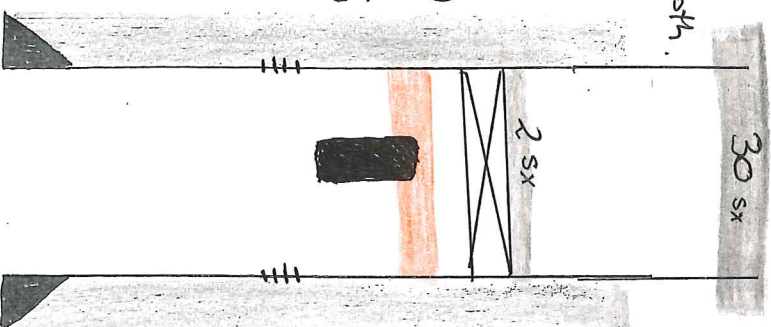

Plug #2
- Balanced Plug: 4050'-3950'
30 sx.

Plug #1
cast iron bridge plug: SET AT 6,370''
- 25x of cement Top.

Production Casing:
5-1/2" OD
16 lbs/ft
Depth - 6,878'
200 sx of cement to 5,540' (CR)

Reflections: 6,710' - 6,716' (24 holes)
D-Sand