


# LOCATION DRAWING


PRONGHORN F-18 PAD

SECTION: 18  
TOWNSHIP: 5N  
RANGE: 61W

NOTE: ALL DISTANCES ARE MEASURED FROM THE PRONGHORN 11-14-18HNB WELL HEAD.

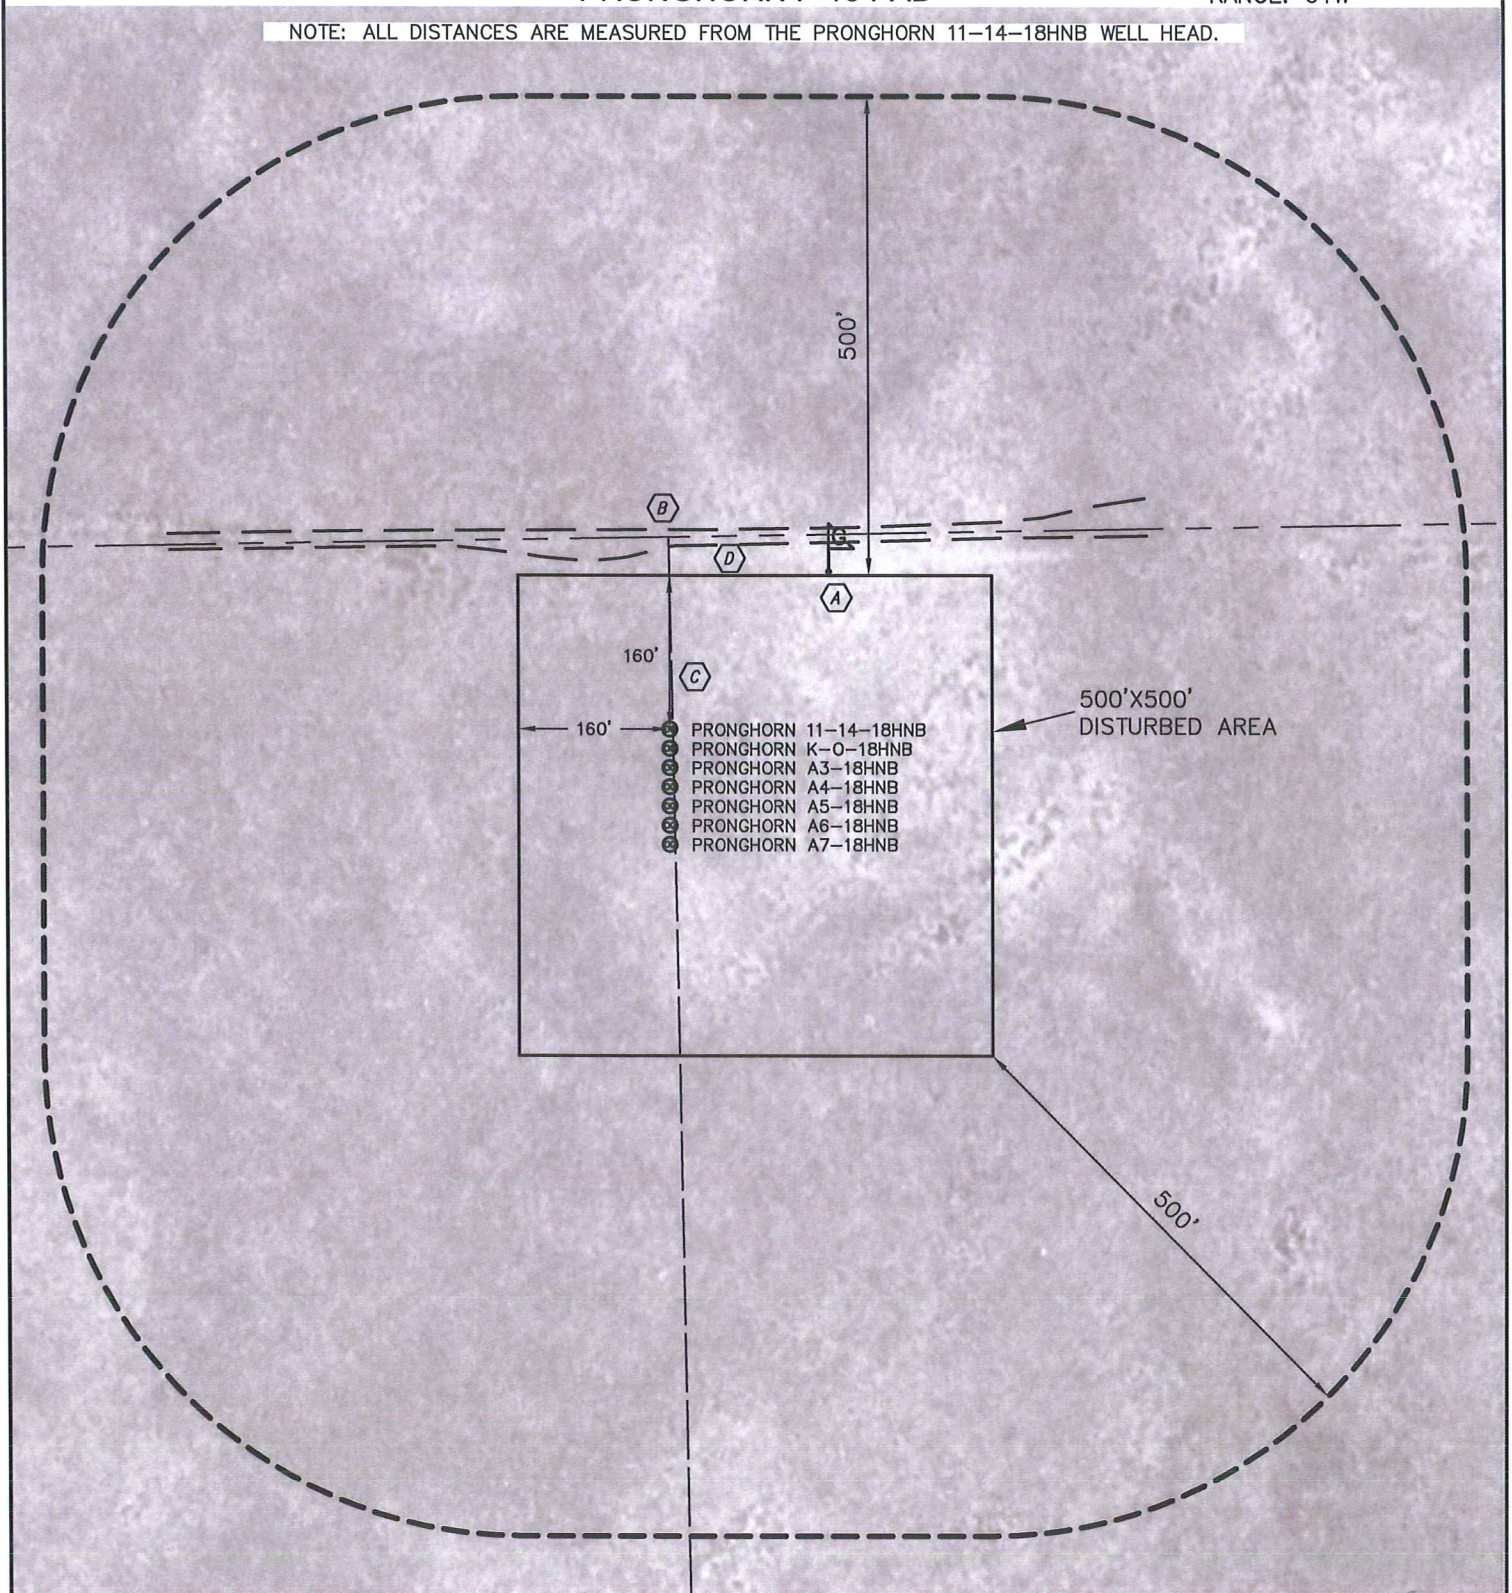

- A GAS LINE MARKER 235' NORTHEAST
- B SECTION/PROPERTY LINE 200' NORTH
- C SIXTEENTH SECTION LINE 3' EAST
- D SOUTH EDGE GRAVEL ROAD 185' NORTH

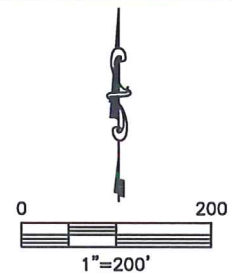

PROJECT#: 2013600