Kicking Bird 21-16 Wellbore Diagram (P&A)

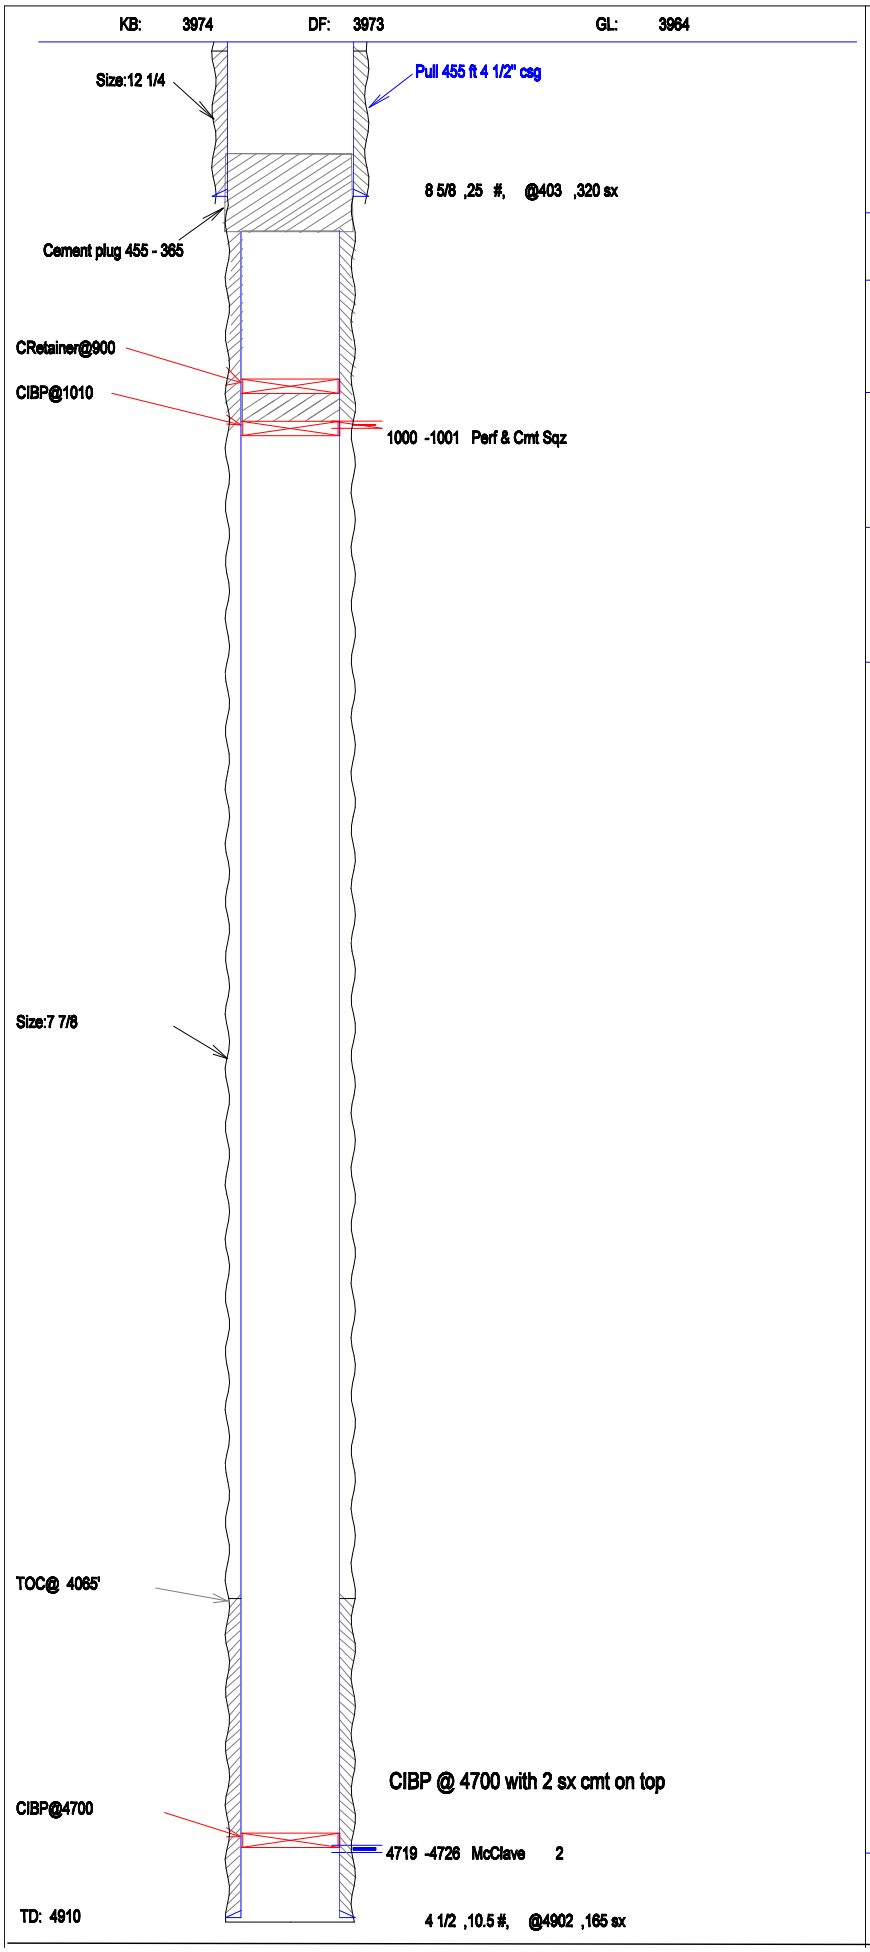

Ranch Oil Company

Well: ,21-16 ,71450—21-
Operator:
Location: N2 Sec 16-T21S-R48W Bent Co., C
Legal: Kicking Bird 21-16
County: ,
LAT/Long: 38.227653 /-102.807124

Dir:

Spud Date: 6/12/1980
Drilling Finished: 6/20/1980
Completion Date: 8/5/1980
First Production: 8/5/1980

PUMPING DATA:
PU:
PM:
BHP:
Anchor:

PRODUCTION FACILITY:

HISTORY:
3/28/2012 Additional P&A info: Set CIBP's @ 4700 and 1010 ft. Perf 1000-1001, set cmt rtr @ 900 ft, & cmt sqz w/40 sx Class A.
Rec'd 455 ft 4 1/2" csg. Set 50 sx cmt from 365-455 ft. Plug tagged. Set 15 sx cmt at surface.
Wireline contractor Peak Wireline. Cmt contractor Allied Oil & Gas.

10/27/2013 Final P&A. Cut off csg & weld plate (cap).

Input by: E.O.F.
Approved by: C.R.D
Last Update: 2/25/2014