


Section 20
T. 6 S., R. 94 W.

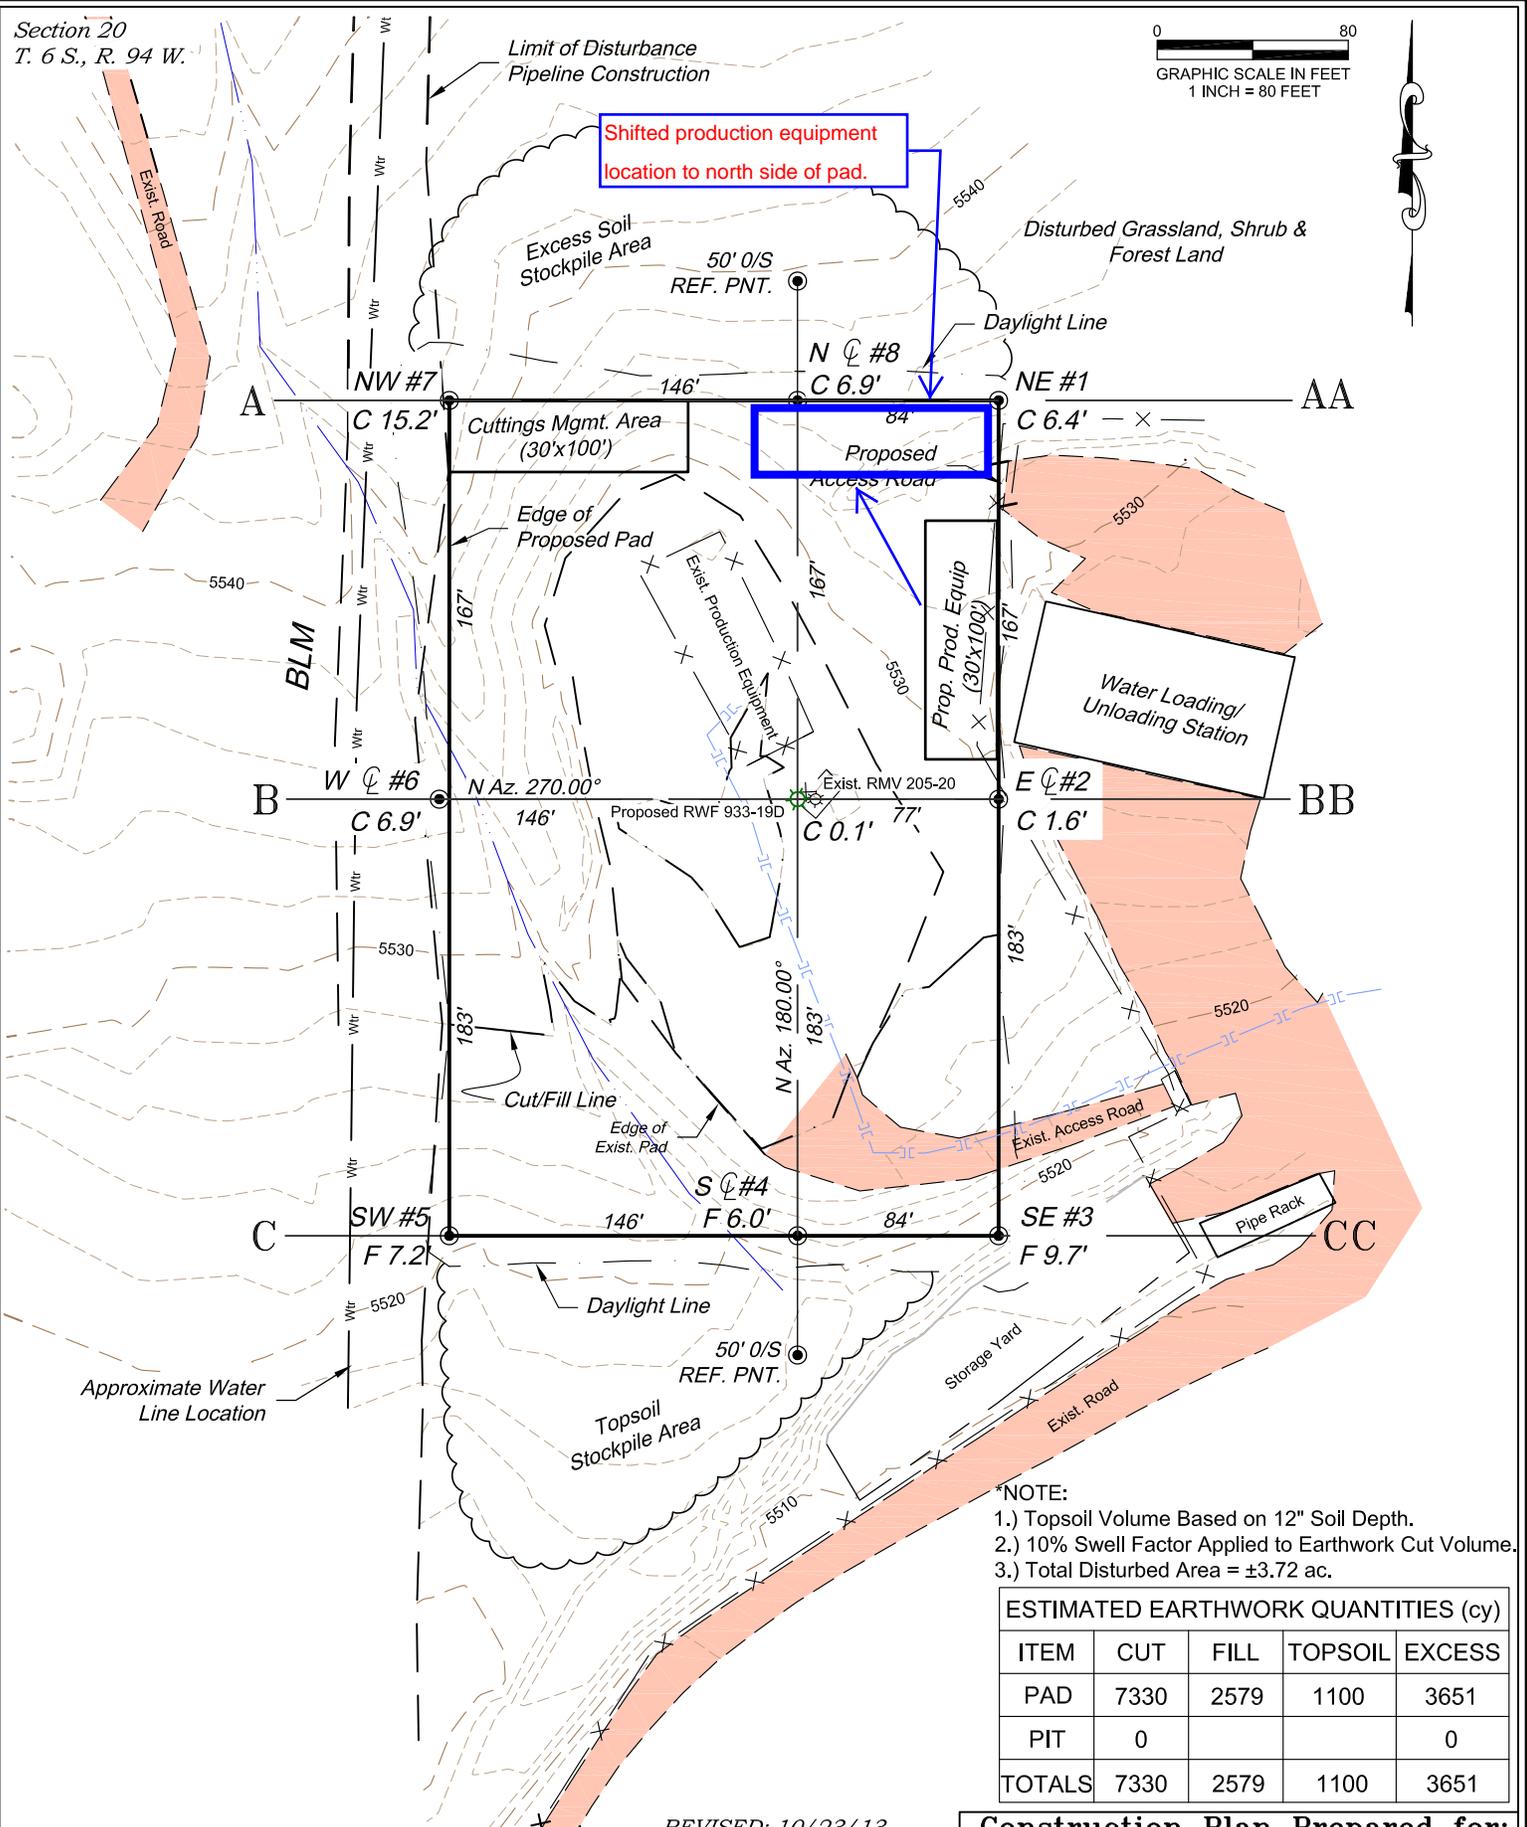

Shifted production equipment
location to north side of pad.

*NOTE:
1.) Topsoil Volume Based on 12" Soil Depth.
2.) 10% Swell Factor Applied to Earthwork Cut Volume.
3.) Total Disturbed Area = ±3.72 ac.

ESTIMATED EARTHWORK QUANTITIES (cy)				
ITEM	CUT	FILL	TOPSOIL	EXCESS
PAD	7330	2579	1100	3651
PIT	0			0
TOTALS	7330	2579	1100	3651

REVISED: 10/23/13

SCALE: 1" = 80'
DATE: 10/17/13
PLAT: 2 of 7
PROJECT: Valley
DFT: cws

Construction Plan Prepared for:
WPXENERGY WPX Energy Rocky Mountain, LLC

*RMV 205-20 Drill Pad - Plat 2
CONSTRUCTION LAYOUT*

136 East Third Street
Rifle, Colorado 81650
Ph. (970) 625-2720
Fax (970) 625-2773

BOOKCLIFF
Survey Services, Inc.

K:\2012 WILLIAMS VALLEY\RMV 205-20 Inj Well\RMV 205-20 Inj.dwg, 10/24/2013 7:21:58 AM