


WELL LOCATION PLOT

for JAVERNICK OIL - DRAPER NO. 4

LOCATED IN THE NE 1/4 OF SECTION 28,
T. 20 S., R. 69 W. OF THE 6TH P.M.,
FREMONT COUNTY, COLORADO

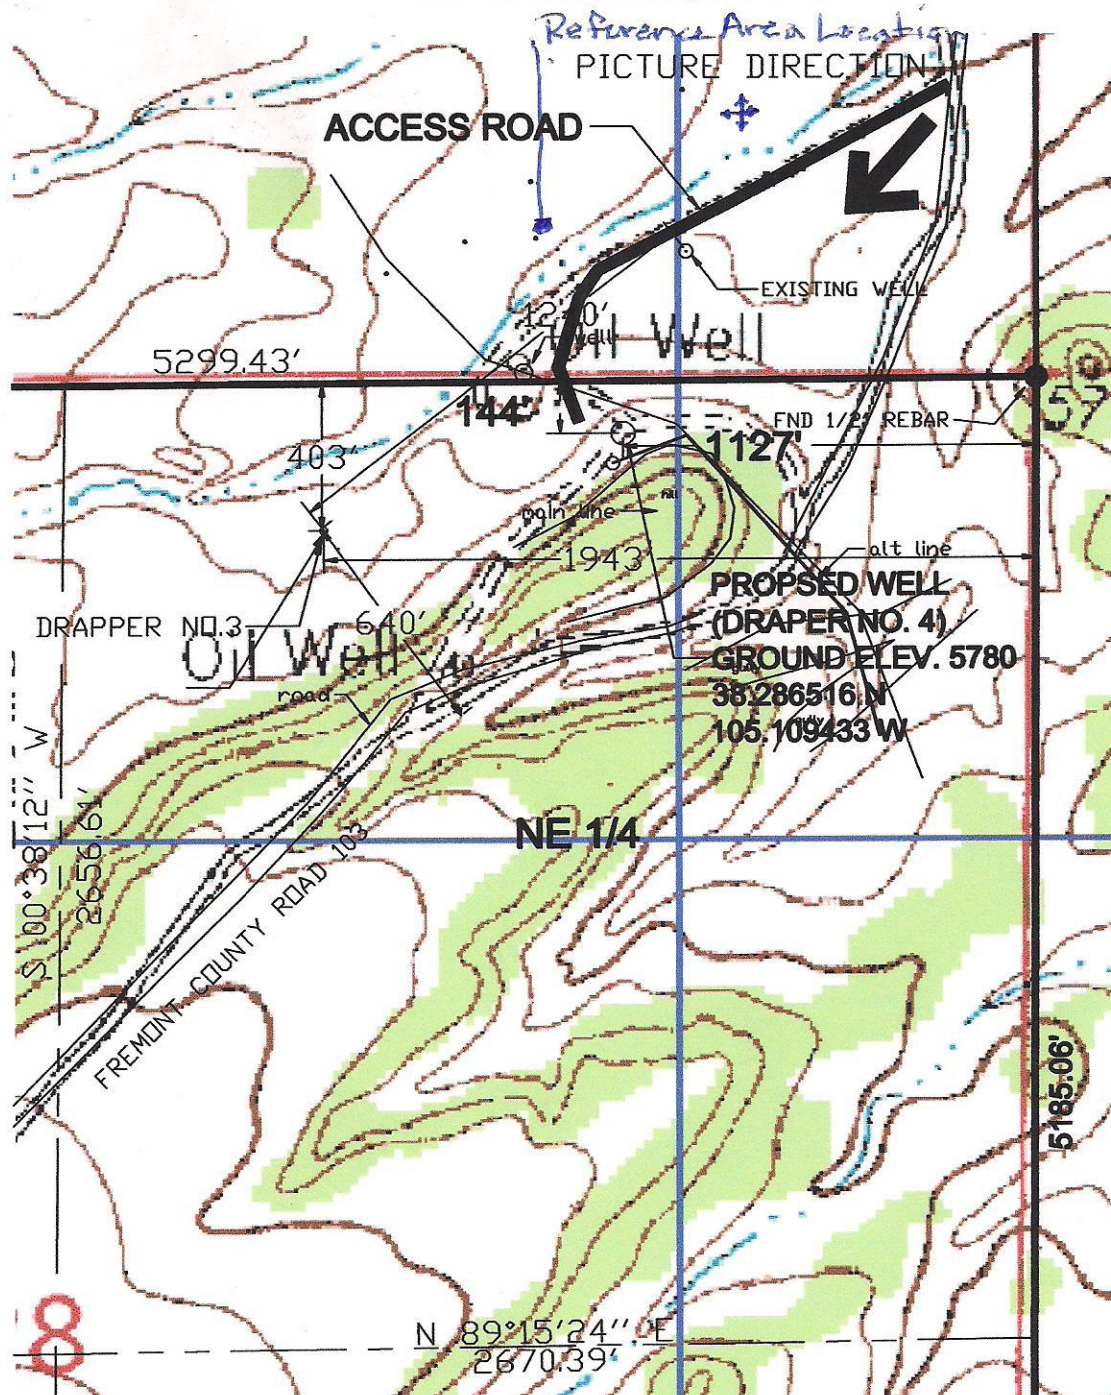

Scale 1" = 500'

REFERENCE AREA MAP

**CORNERSTONE
LAND SURVEYING, LLC**

1022 PHAY AVE.
CANON CITY, COLORADO 81212
719-275-8881

APRIL 8, 2013

JOB # JAVOILB1