


WPX Energy Rocky Mountain LLC  
FEDERAL RGU 22-27-198  
SULPHUR CREEK Field

SHL 2077' FNL 2141' FWL (SE/4 NW/4) LOT 6 Section 27 T1S R98W 6th PM  
BHL 1433' FNL 1924' FWL (SE/4 NW/4) Section 27 T1S R98W 6th PM  
RIO BLANCO County Colorado

Formation Tops  
(Measured Depths)

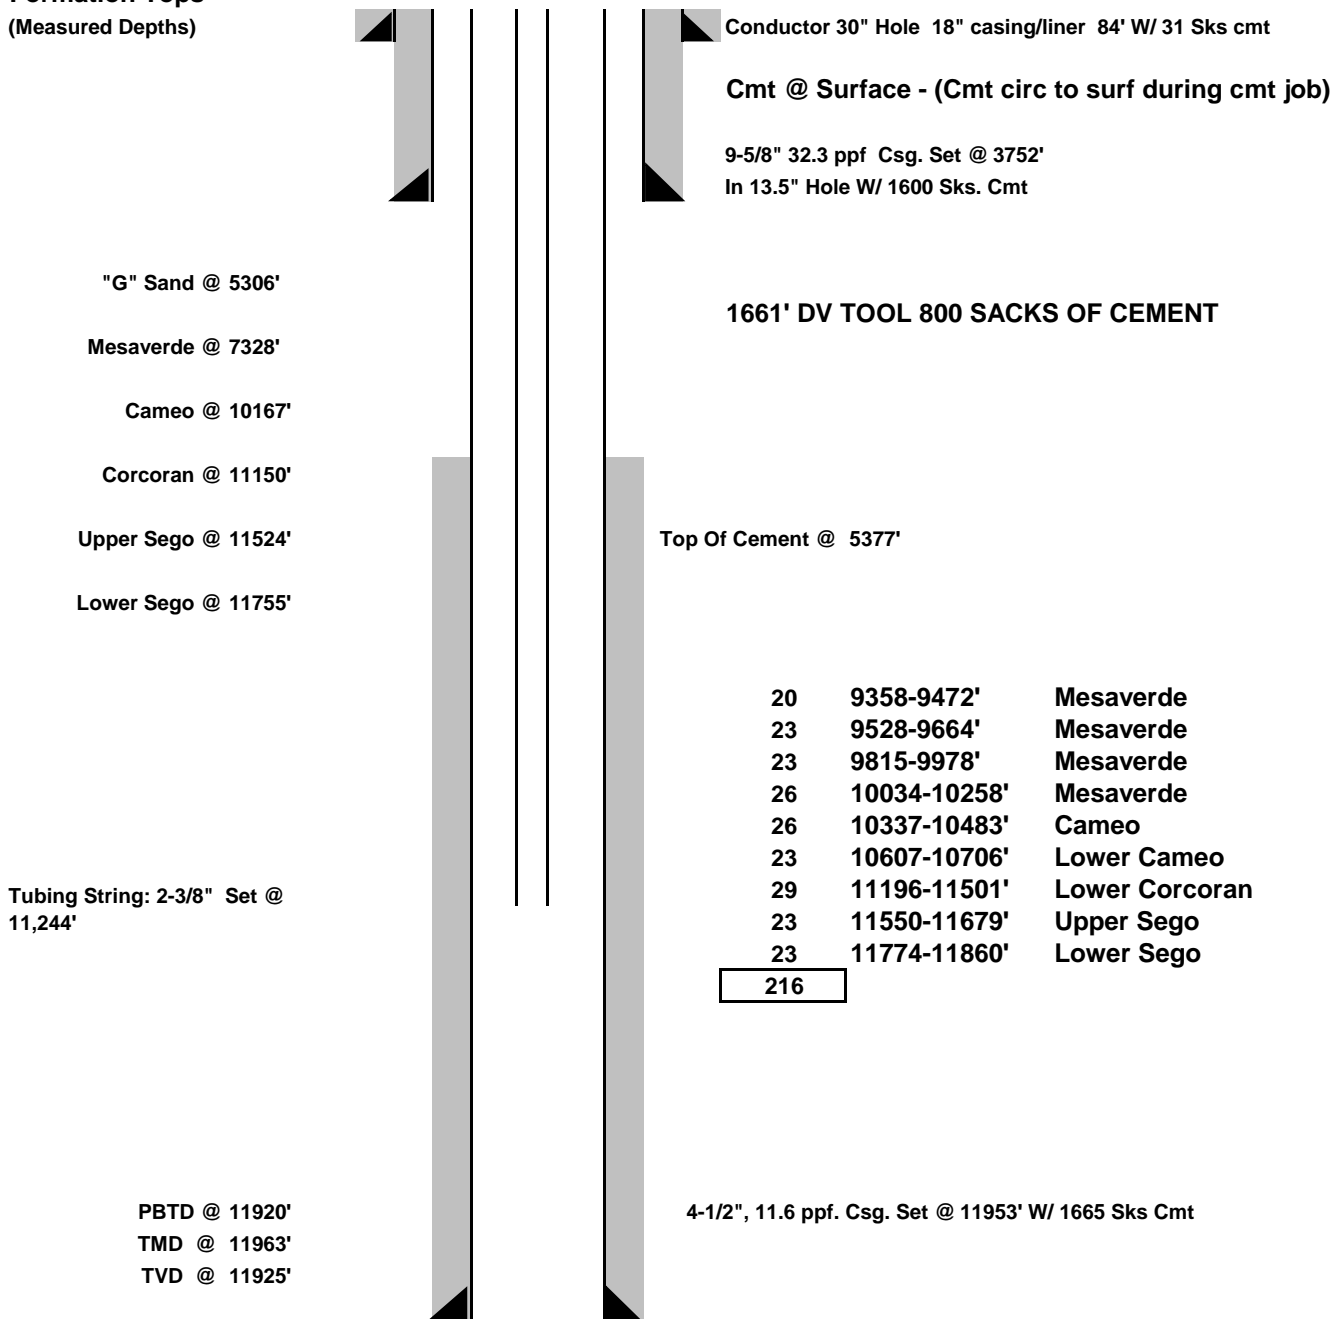

DATE CREATED: 2/26/2014

NOTE: THIS IS NOT TO SCALE.  
\*\*FINAL\*\*