



Physical Address: 345 Comanche St.  
Mail to: Box 384, Kiowa, CO 80117  
Ph. 303-621-8672 - Fax 303-621-7749  
www.highprairiesurvey.com

Job # 13205 Blackcomb #12-14


Inv # 2606

High Prairie Surveying of Kiowa, Colorado, in accordance with a request from **Night Hawk Production LLC**, has determined the location of **BLACKCOMB #12-14** to be **2245 feet FSL**, and **640 feet FWL**, (90° off Section lines) of **SECTION 14**, Township **6s**, Range **54w** of the 6th Principal Meridian, **Lincoln County**, Colorado.

Date: Staked on 08/06/13 drawn on 08/13/13.

Re: Staked by Elijah Frane  
Drawn: Drawn by Dustin Cotter

## Topographic Exhibit

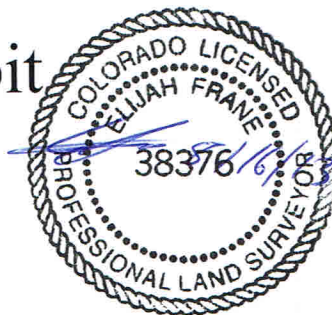

NIGHT HAWK PRODUCTION LLC.  
SW 1/4 SEC. 14-6s-54w  
BLACKCOMB #12-14  
LINCOLN, Co. COLORADO

