


WPX Energy Rocky Mountain LLC
FEDERAL RU 331-5
RULISON Field

SHL 225' FNL 2615' FWL (SE/4 NW/4) Lot 2 Section 5 T7S R93W 6th PM
BHL 495' FNL 1946' FEL (NW/4 SE/4) Section 5 T7S R93W 6th PM
Garfield County Colorado

Formation Tops
(Measured Depths)

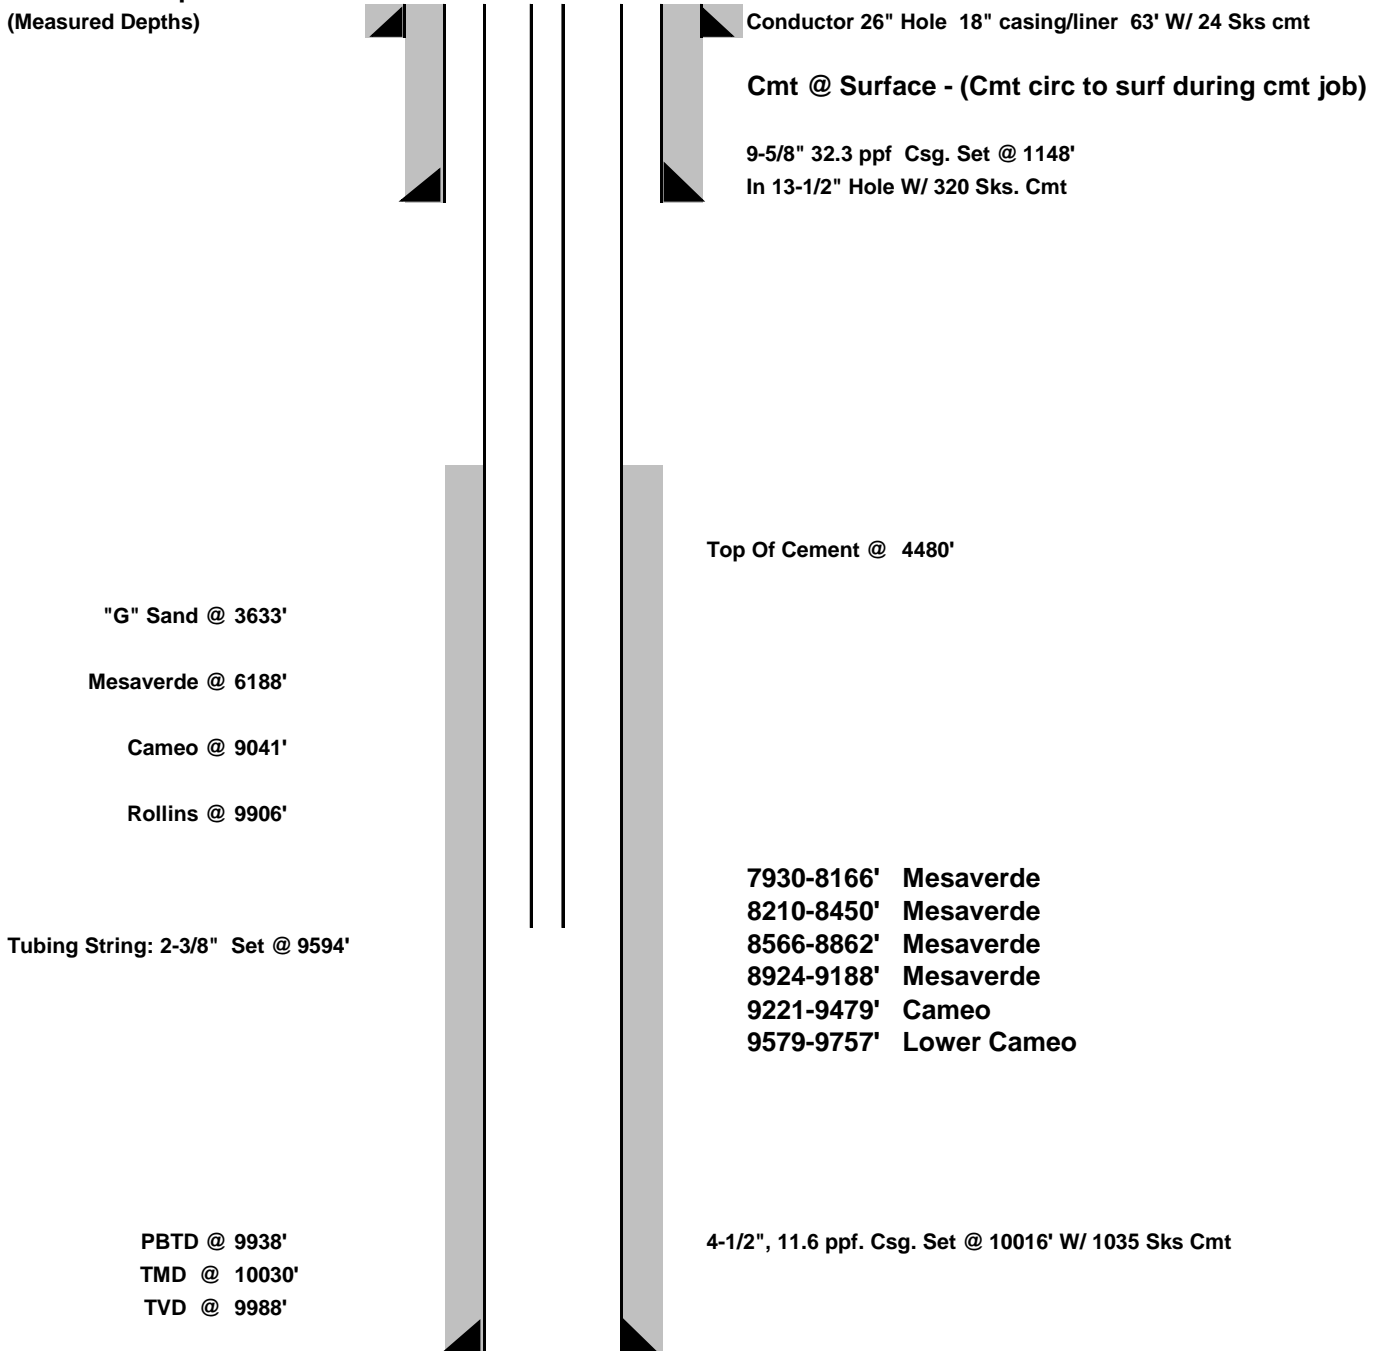

DATE CREATED: 2/19/2014

NOTE: THIS IS NOT TO SCALE.
FINAL