


Well Name: BEEBE DRAW 11-1

VERTICAL - ORIGINAL HOLE, 3/4/2014 8:47:19 AM

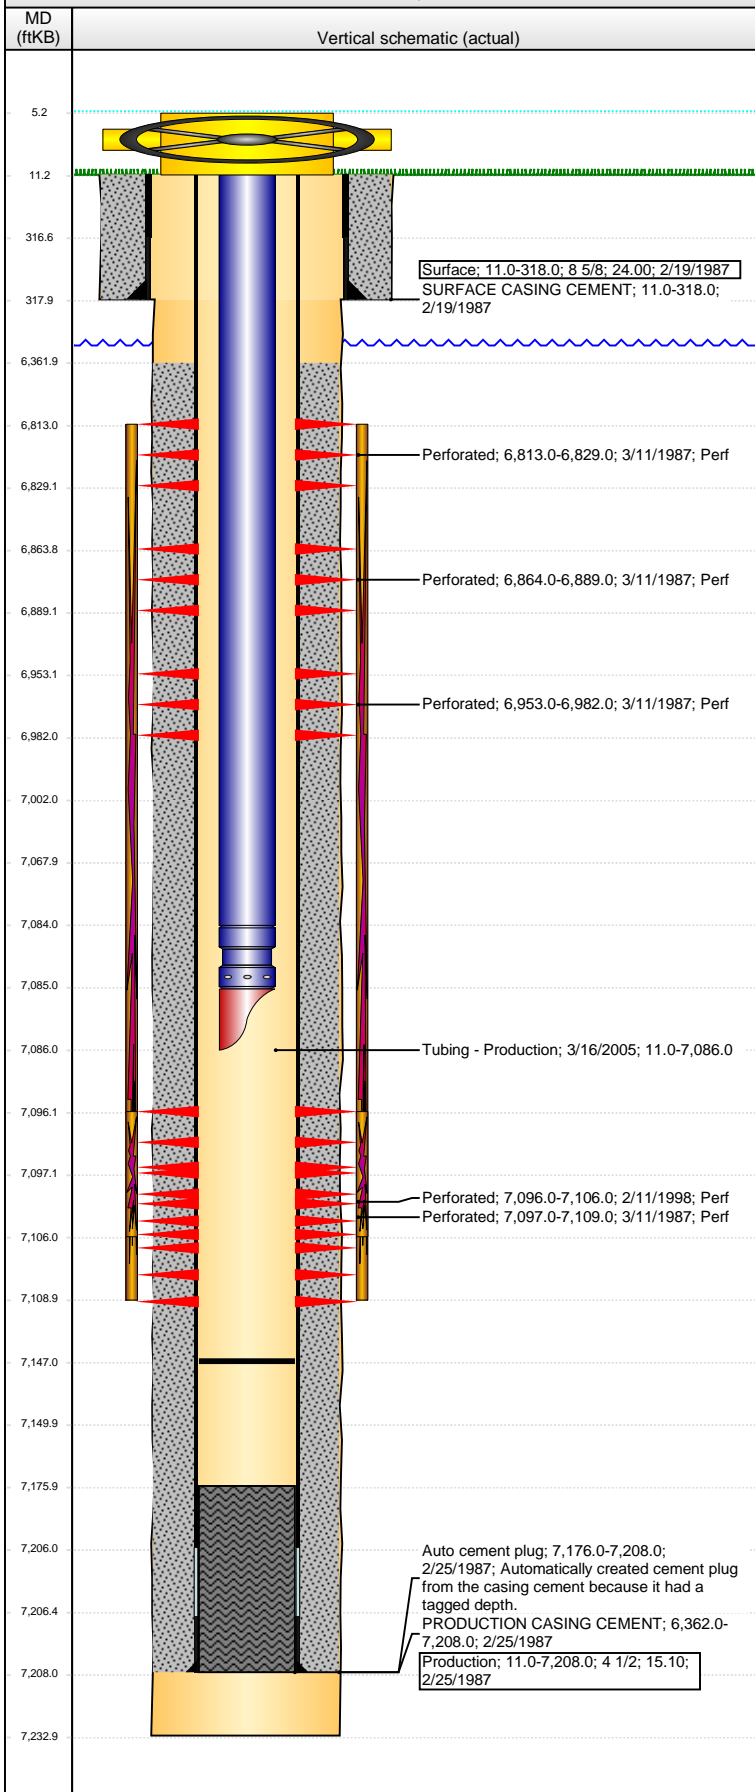

Well Header

| | | | |
|--|-------------------------------|------------------------|-------------------------|
| API 05-123-13346 | Business Unit WATTENBERG | District 15 | Well Config VERTICAL |
| Original KB Elevation (ft) 4,820.00 | KB - GL / MSL (ftKB) 11.00 | Spud Date 2/19/1987 | P & A Date |

Comment

Directions To Well

Congressional Location

| | | | | | | | | |
|-----------|-----------|-----------------|-----------------|---------------|-----------------|--------------|-------------|------------------|
| Quarter 1 | Quarter 2 | Quarter 3 NW | Quarter 4 NE | Section 11 | Township 3 N | Twntshp N... | Range 65 | Rng E/W Dir W |
|-----------|-----------|-----------------|-----------------|---------------|-----------------|--------------|-------------|------------------|

Bottom Hole Location

| | | | |
|---------------------------|------------------|-------------------------|------------------|
| North-South Distance (ft) | From N or S Line | East-West Distance (ft) | From E or W Line |
|---------------------------|------------------|-------------------------|------------------|

Plug Back Total Depths

| Date | Depth (ftKB) | Method | Com |
|-----------|--------------|----------------|----------------------|
| 2/25/1987 | 7,176.0 | CASING TALLY | TOP OF FLOAT COLLAR |
| 3/4/1987 | 6,905.0 | CASED HOLE LOG | DEPTH LOGGER ON CBL |
| 3/16/2005 | 7,147.0 | TAG | MOST RECENT CLEANOUT |

Wellbore Sections

| Section Des | Size (in) | Act Top, MD (ftKB) | Act Btm, MD (ftKB) |
|-------------|-----------|--------------------|--------------------|
| SURFACE | 12 1/4 | 11.0 | 318.0 |
| PRODUCTION | 7 7/8 | 318.0 | 7,233.0 |

Zone Statuses

| Zone Name | Status Date | Status | Job |
|-----------|-------------|--------|---|
| CODELL | 4/18/1987 | PR | DRILLING/COMPLETION - ORIGINAL, 2/19/1987 00:00 |
| NIOBRARA | 4/18/1987 | PR | RE-FRAC, 12/15/1998 00:00 |

Casing Strings

Surface, 318.0ftKB

| Casing Description | Run Date | OD (in) | Wt/Len (l...) | Grade | Top, MD (ft...) | MD (ftKB) |
|--------------------|-----------|---------|---------------|-------|-----------------|-----------|
| Surface | 2/19/1987 | 8 5/8 | 24.00 | | 11.0 | 318.0 |

Production, 7,208.0ftKB

| Casing Description | Run Date | OD (in) | Wt/Len (l...) | Grade | Top, MD (ft...) | MD (ftKB) |
|--------------------|-----------|---------|---------------|-------|-----------------|-----------|
| Production | 2/25/1987 | 4 1/2 | 15.10 | | 11.0 | 7,208.0 |

Cement

| Description | Top Depth (ftKB) | Bottom Depth (ftKB) |
|--------------------------|------------------|---------------------|
| SURFACE CASING CEMENT | 11.0 | 318.0 |
| PRODUCTION CASING CEMENT | 6,362.0 | 7,208.0 |

Tubing Components

| Item Des | OD (in) | Wt (lb/ft) | Grade | Jts | Len (ft) | Btm (ftKB) | Btm (TVD) (ftKB) |
|-------------|---------|------------|-------|-----|----------|------------|------------------|
| Tubing | 2 3/8 | 4.70 | | 229 | 7,073.00 | 7,084.0 | |
| Seal Nipple | 2 3/8 | 4.70 | | | 1.00 | 7,085.0 | |
| MS | 2 3/8 | 4.70 | | | 1.00 | 7,086.0 | |

Perforation Data

| Zone | Bnch/St g | Entered Shot Total | Top (ftKB) | Btm (ftKB) | Date |
|-------------------------|-----------|--------------------|------------|------------|-----------|
| NIOBRARA, ORIGINAL HOLE | A | 3 | 6,813.00 | 6,829.00 | 3/11/1987 |
| NIOBRARA, ORIGINAL HOLE | B | 5 | 6,864.00 | 6,889.00 | 3/11/1987 |
| NIOBRARA, ORIGINAL HOLE | C | 4 | 6,953.00 | 6,982.00 | 3/11/1987 |
| CODELL, ORIGINAL HOLE | | 4 | 7,096.00 | 7,106.00 | 2/11/1998 |
| CODELL, ORIGINAL HOLE | | 7 | 7,097.00 | 7,109.00 | 3/11/1987 |

Stimulations & Treatments

| Date | Zone | Primary Job Type |
|------------------|--------------------------------|--------------------------------|
| 3/13/1987 | NIOBRARA-CODELL, ORIGINAL HOLE | DRILLING/COMPLETION - ORIGINAL |
| Technical Result | Tech Result Details | Tech Result Note |

Comment

Frac Niobrara/Codell Limited Entry Frac

| Date | Zone | Primary Job Type |
|------------------|-----------------------|------------------|
| 12/15/1998 | CODELL, ORIGINAL HOLE | RE-FRAC |
| Technical Result | Tech Result Details | Tech Result Note |

Comment

ReFrac Codell only

Well Name: BEEBE DRAW 11-1

VERTICAL - ORIGINAL HOLE, 3/4/2014 8:47:22 AM

Other In Hole

| Run Date | Des | OD (in) | Top (ftKB) | Btm (ftKB) |
|----------|-----|---------|------------|------------|
| | | | | |

Logs

| Date | Type | Top, MD (ftKB) | Btm, MD (ftKB) |
|-----------|---------------------|----------------|----------------|
| 2/24/1987 | COMPENSATED DENSITY | 298.2 | 7,225.0 |
| 2/24/1987 | INDUCTION | 298.2 | 7,225.0 |
| 3/4/1987 | CBL/CCL/GR | 6,300.0 | 6,902.0 |

