




Lat40°, Inc. 1635 Foxtrail Drive, Suite 325 Loveland, CO 970-776-3321

PLUGGED & ABANDONED WELL EXHIBIT

THIS MAP DOES NOT REPRESENT A BOUNDARY SURVEY

SECTION: 18
TOWNSHIP: 5N
RANGE: 61W

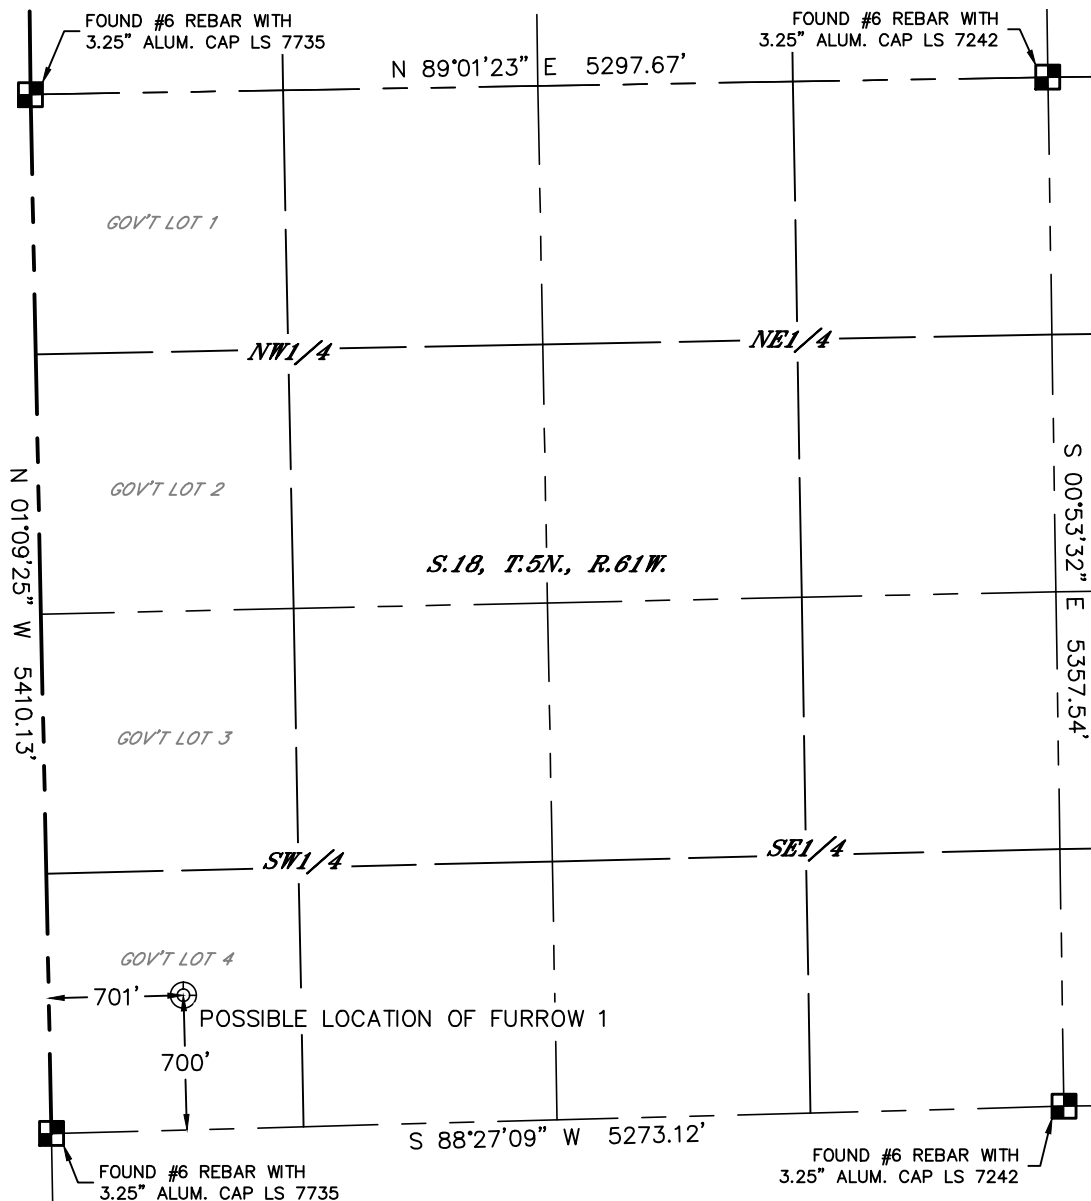

SURFACE LOCATION

LAT: 40.39559°N
LONG: 104.25928°W
PDOP: 2.6
ELEV: 4542'
1/4,1/4: SW1/4SW1/4

SURFACE DESCRIPTION

FOUND 12" BENT STEEL PIPE FLUSH WITH GRADE, FILLED WITH GROUT LIKE MATERIAL. SET ORANGE LATHE WITH PINK FLAGGING.

LEGEND

- = ALIQUOT MONUMENT AS DESCRIBED
- = CALCULATED POSITION

DATE: 1/24/2014
PROJECT#: 2013173



Lat40°, Inc. 1635 Foxtrail Drive, Suite 325 Loveland, CO 970-776-3321

P&A WELL LOCATION PICTURES

FURROW 1

SECTION: 18
TOWNSHIP: 5N
RANGE: 61W

DATE: 1/22/2014



VIEW NORTH



VIEW WEST



VIEW EAST



VIEW SOUTH

DATE: 1/24/2014
PROJECT#: 2013173