


WELL NAME: Smithberger #1
OPERATOR: Plains Exploration
COMP ZONE: J Sand
LOCATION: 10N 59W S27 NE NW

COUNTY: Weld
STATE: Colorado
API : 05-123-05756

SPUD: 8/25/55
P&A: 9/11/55
GL: 5,095'

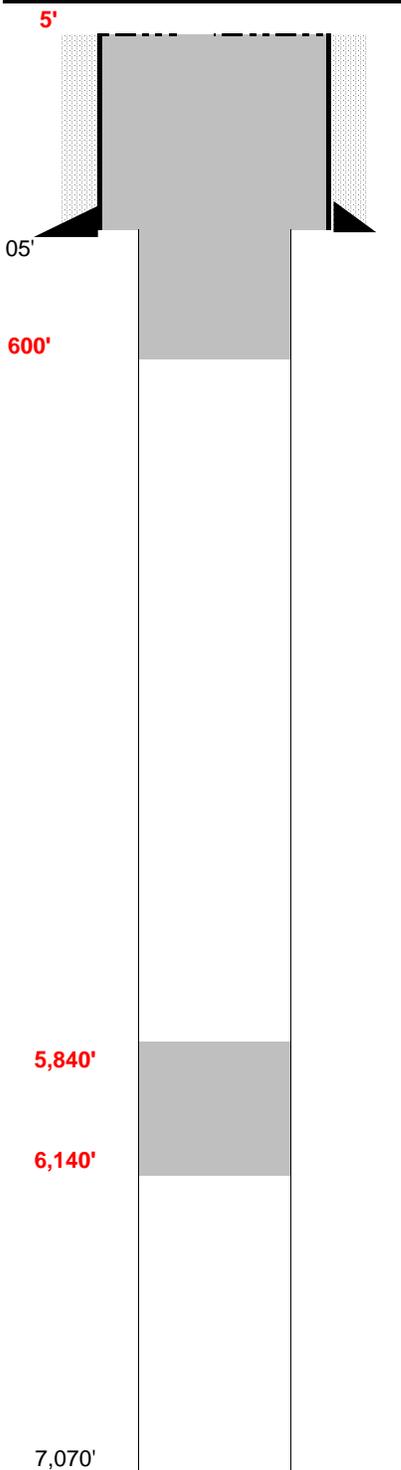

SURFACE CASING

DEPTH: 205' SIZE: 10.75" GRADE: _____ WT (#/ft): 32.8
 CEMENT: 175 sx
 COMMENTS: _____

PRODUCTION CASING

DEPTH: _____ SIZE: _____ GRADE: _____ WT (#/ft): _____
 CEMENT: _____ TOC: _____
 COMMENTS: _____

PERFS: _____ - _____ PROD ZONE 1: _____
 PERFS: _____ - _____ ZONE 2: _____
 PERFS: _____ - _____ ZONE 3: _____

PREVIOUS PLUGS

RECOVERED: _____ SIZE: _____
 CMT 1: 205' - 175' COMMENT: 15 sx
 CMT 2: 20' - 0' COMMENT: 10 sx
 CMT 3: _____ - _____ COMMENT: _____

OTHER: Plug #1: 135 sx cement from 6140' to 5840' (300' above Niobrara)
 Plug #2: 300 sx cement from 600' to surface (Isolating FW Sands)

FORMATIONS:

HYGIENE	<u>3,665'</u>
NIOBRARA	<u>6,140'</u>
TIMPAS	<u>6,408'</u>
CARLILE	<u>6,456'</u>
MOWRY	<u>6,805'</u>
D SAND	<u>6,894'</u>
J SAND	<u>7,009'</u>