


WELL NAME: State-Husky #1
OPERATOR: Bennett Petroleum Corp.
COMP ZONE: Dry Hole
LOCATION: 9N 60W S36 NW NE

COUNTY: Weld
STATE: Colorado
API : 05-123-33402

SPUD: 6/28/75
P&A: 7/9/75
GL: 4,886'

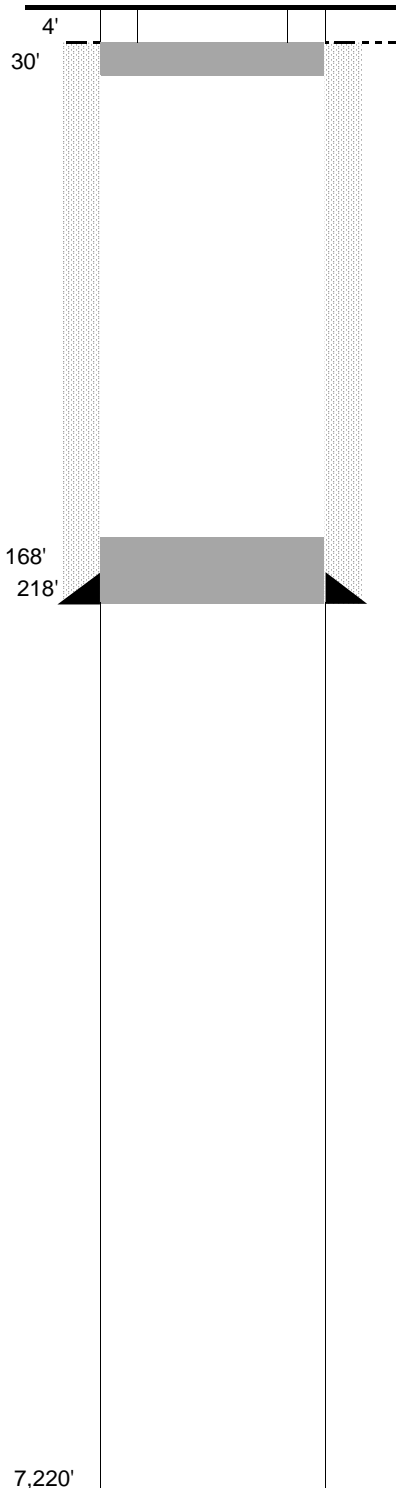

SURFACE CASING

DEPTH: 218' SIZE: 8.625" GRADE: J-55 WT (#/ft): 24.0
CEMENT: 200 sx of Class G + 3% CaCl2
COMMENTS: _____

PRODUCTION CASING

DEPTH: _____ SIZE: _____ GRADE: _____ WT (#/ft): _____
CEMENT: _____ TOC: _____
COMMENTS: _____

PERFS: _____ - _____ PROD ZONE 1: _____
PERFS: _____ - _____ ZONE 2: _____
PERFS: _____ - _____ ZONE 3: _____

PLUGGING REPORT

ZONE 1 CIBP: _____ CMT: _____ OTHER: _____
2 CIBP: _____ CMT: _____ OTHER: _____
3 CIBP: _____ CMT: _____ OTHER: _____

RECOVERED: _____ SIZE: _____
CMT 1: 218' - 168' COMMENT: 15 sx Cement
CMT 2: 30' - 0' COMMENT: 10 sx Cement

OTHER: Cut all casing strings 4' below ground level, weld on plate

FORMATIONS:

NIOBRARA: 6,030'
FORT HAYS 6,326'
CODELL _____
D SAND 6,780'
D SILT 6,846'
J SAND 6,865'