



Baker Oil Tools

Casing Information		
7" 26# J-55		
Burst=	9,960	psi
Collapse=	6,230	psi
Capacity=	0.03826	bbbls/ft

Liner Information		
4-1/2" 11.60# P-110		
Burst=	10,690	psi
Collapse=	7,580	psi
Capacity=	0.01554	bbbls/ft

S-3 LINER TOP	TVD
5,585.53	6,904.00
Casing Shoe	KOP
6,585.00	5,650.00

Dimensional Information			
Component	OD	ID	dim
S-3	5.875	3.875	in
RE Packers	5.687	4.000	in
Sleeves	5.625	Ball Seat	in

FracPoint Space Out Diagram

BILL BARRETT CORPORATION

Anschutz State 5-62-25-0108XBH



Displacements	BBLS	GALS
Liner Top	213.70	8,975
3.625" SLV	231.87	9,739
3.500" SLV	235.64	9,897
3.375" SLV	239.34	10,052
3.250" SLV	243.12	10,211
3.125" SLV	247.00	10,374
3.000" SLV	250.81	10,534
2.875" SLV	254.74	10,699
2.750" SLV	258.60	10,861
2.625" SLV	262.53	11,026

Displacements	BBLS	GALS
2.500" SLV	266.34	11,186
2.438" SLV	269.67	11,326
2.375" SLV	272.83	11,459
2.313" SLV	276.08	11,595
2.250" SLV	279.31	11,731
2.188" SLV	282.58	11,868
2.125" SLV	285.79	12,003
2.063" SLV	289.25	12,148
2.000+"P" SLV	293.11	12,311
BALL SEAT	293.93	12,345
Float Shoe	294.67	12,376


Length of Zone - FT			
Zone 1	215.19	Zone 10	245.89
Zone 2	242.78	Zone 11	252.94
Zone 3	206.20	Zone 12	247.00
Zone 4	214.81	Zone 13	253.92
Zone 5	204.58	Zone 14	246.00
Zone 6	206.30	Zone 15	249.43
Zone 7	209.43	Zone 16	232.29
Zone 8	206.94	Zone 17	245.38
Zone 9	250.64	Zone 18	240.69



Baker Oil Tools



Bill Barrett Corporation

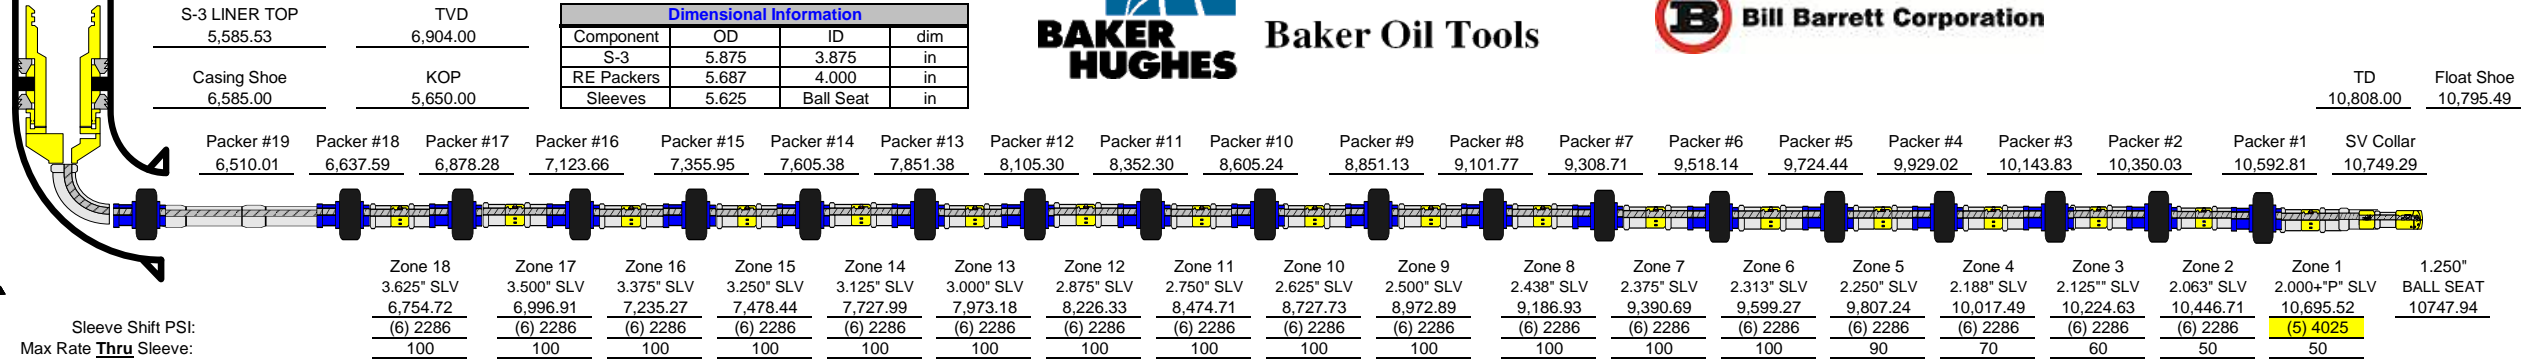

7.5.1-1F4 Frac-Point Space Out Diagram