

KERR-MCGEE OIL AND GAS ONSHORE LP

SACK, ALBERT UNIT 1

SW NE 22 1N 67W -- --

WELD,COLORADO

02/26/2014

AREA: W3

ROUTE: W34 Spud: 11/19/1973


WINS No.: 73782

AFE/WO#: 88483215

API#: 0512307902

GL:KB:MTD:TVD:LOG MD:PBMD:PBTVD:Directions:

RD 8 & RD 21, S 1/4 MI, W 1/4 MI, INTO

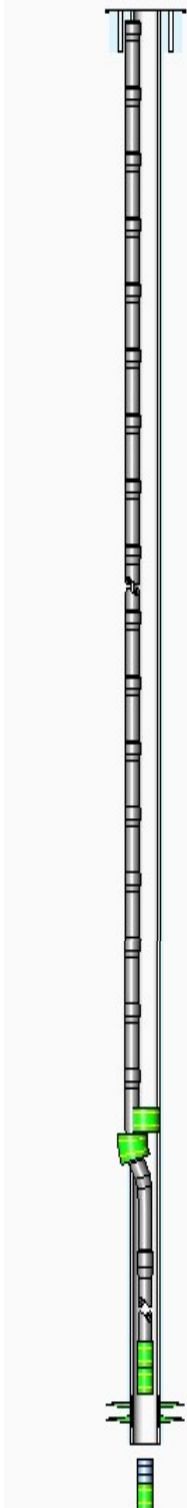

| <u>HOLE SECTIONS</u> | <u>Size</u> | <u>Top</u> | <u>Btm</u> | <u>TD Date</u> | | | |
|----------------------|-------------------|---------------|--------------------|----------------|--------------|---------------|------------------------------|
| <u>TUBULARS</u> | <u>Tool Type</u> | <u>Joints</u> | <u>Size</u> | <u>Weight</u> | <u>Grade</u> | <u>Thread</u> | <u>Top D</u> <u>Bottom D</u> |
| 8 5/8 IN CASING | Casing | 5 | 8.63 | | | | 0 204 |
| 4 1/2 IN CASING | Casing | 194 | 4.50 | | | | 0 8162 |
| PRODUCTION TUBING | Tubing | 265 | 2.38 | | | | 0 8259 |
| | Seating Nipple | | 2.38 | | | | 8259 8260 |
| | Notched Collar | | 2.38 | | | | 8260 8261 |
| PRODUCTION TUBING | Tubing | 221 | 2.38 | 4.70 | J-55 | 8RD EUE | 11 6853 |
| | Unknown | 1 | 4.50 | | | | 6853 6859 |
| | Tubing | 37 | 2.38 | 4.70 | J-55 | 8RD EUE | 6859 8005 |
| | XN Profile Nipple | 1 | 2.38 | | | | 8005 8006 |
| | Notched Collar | 1 | 2.38 | | | | 8006 8007 |
| PACKER | Unknown | 1 | 4.50 | | | | 6841 6847 |
| <u>CEMENT JOBS</u> | <u>Stage</u> | <u>Sacks</u> | <u>Cement Jobs</u> | | <u>Top D</u> | <u>Btm D</u> | <u>cbl</u> |
| 8 5/8 IN CASING | PRIMARY | 200 | LEAD CEMENT | | 0 | 204 | No |
| 4 1/2 IN CASING | PRIMARY | 400 | LEAD CEMENT | | 0 | 8162 | No |
| 4 1/2 IN CASING | SQUEEZE JOB | | | | 6800 | 7350 | No |
| 4 1/2 IN CASING | SQUEEZE JOB | | | | 6800 | 6850 | No |
| <u>PERFORATIONS</u> | <u>Formation</u> | <u>Zone</u> | <u>Top</u> | <u>Btm</u> | <u>Date</u> | <u>Reason</u> | <u>Comments</u> |
| | J SAND | | 8031 | 8055 | 11/26/1973 | | |

Comments: