


MD (ftKB)

Directional schematic (actual)

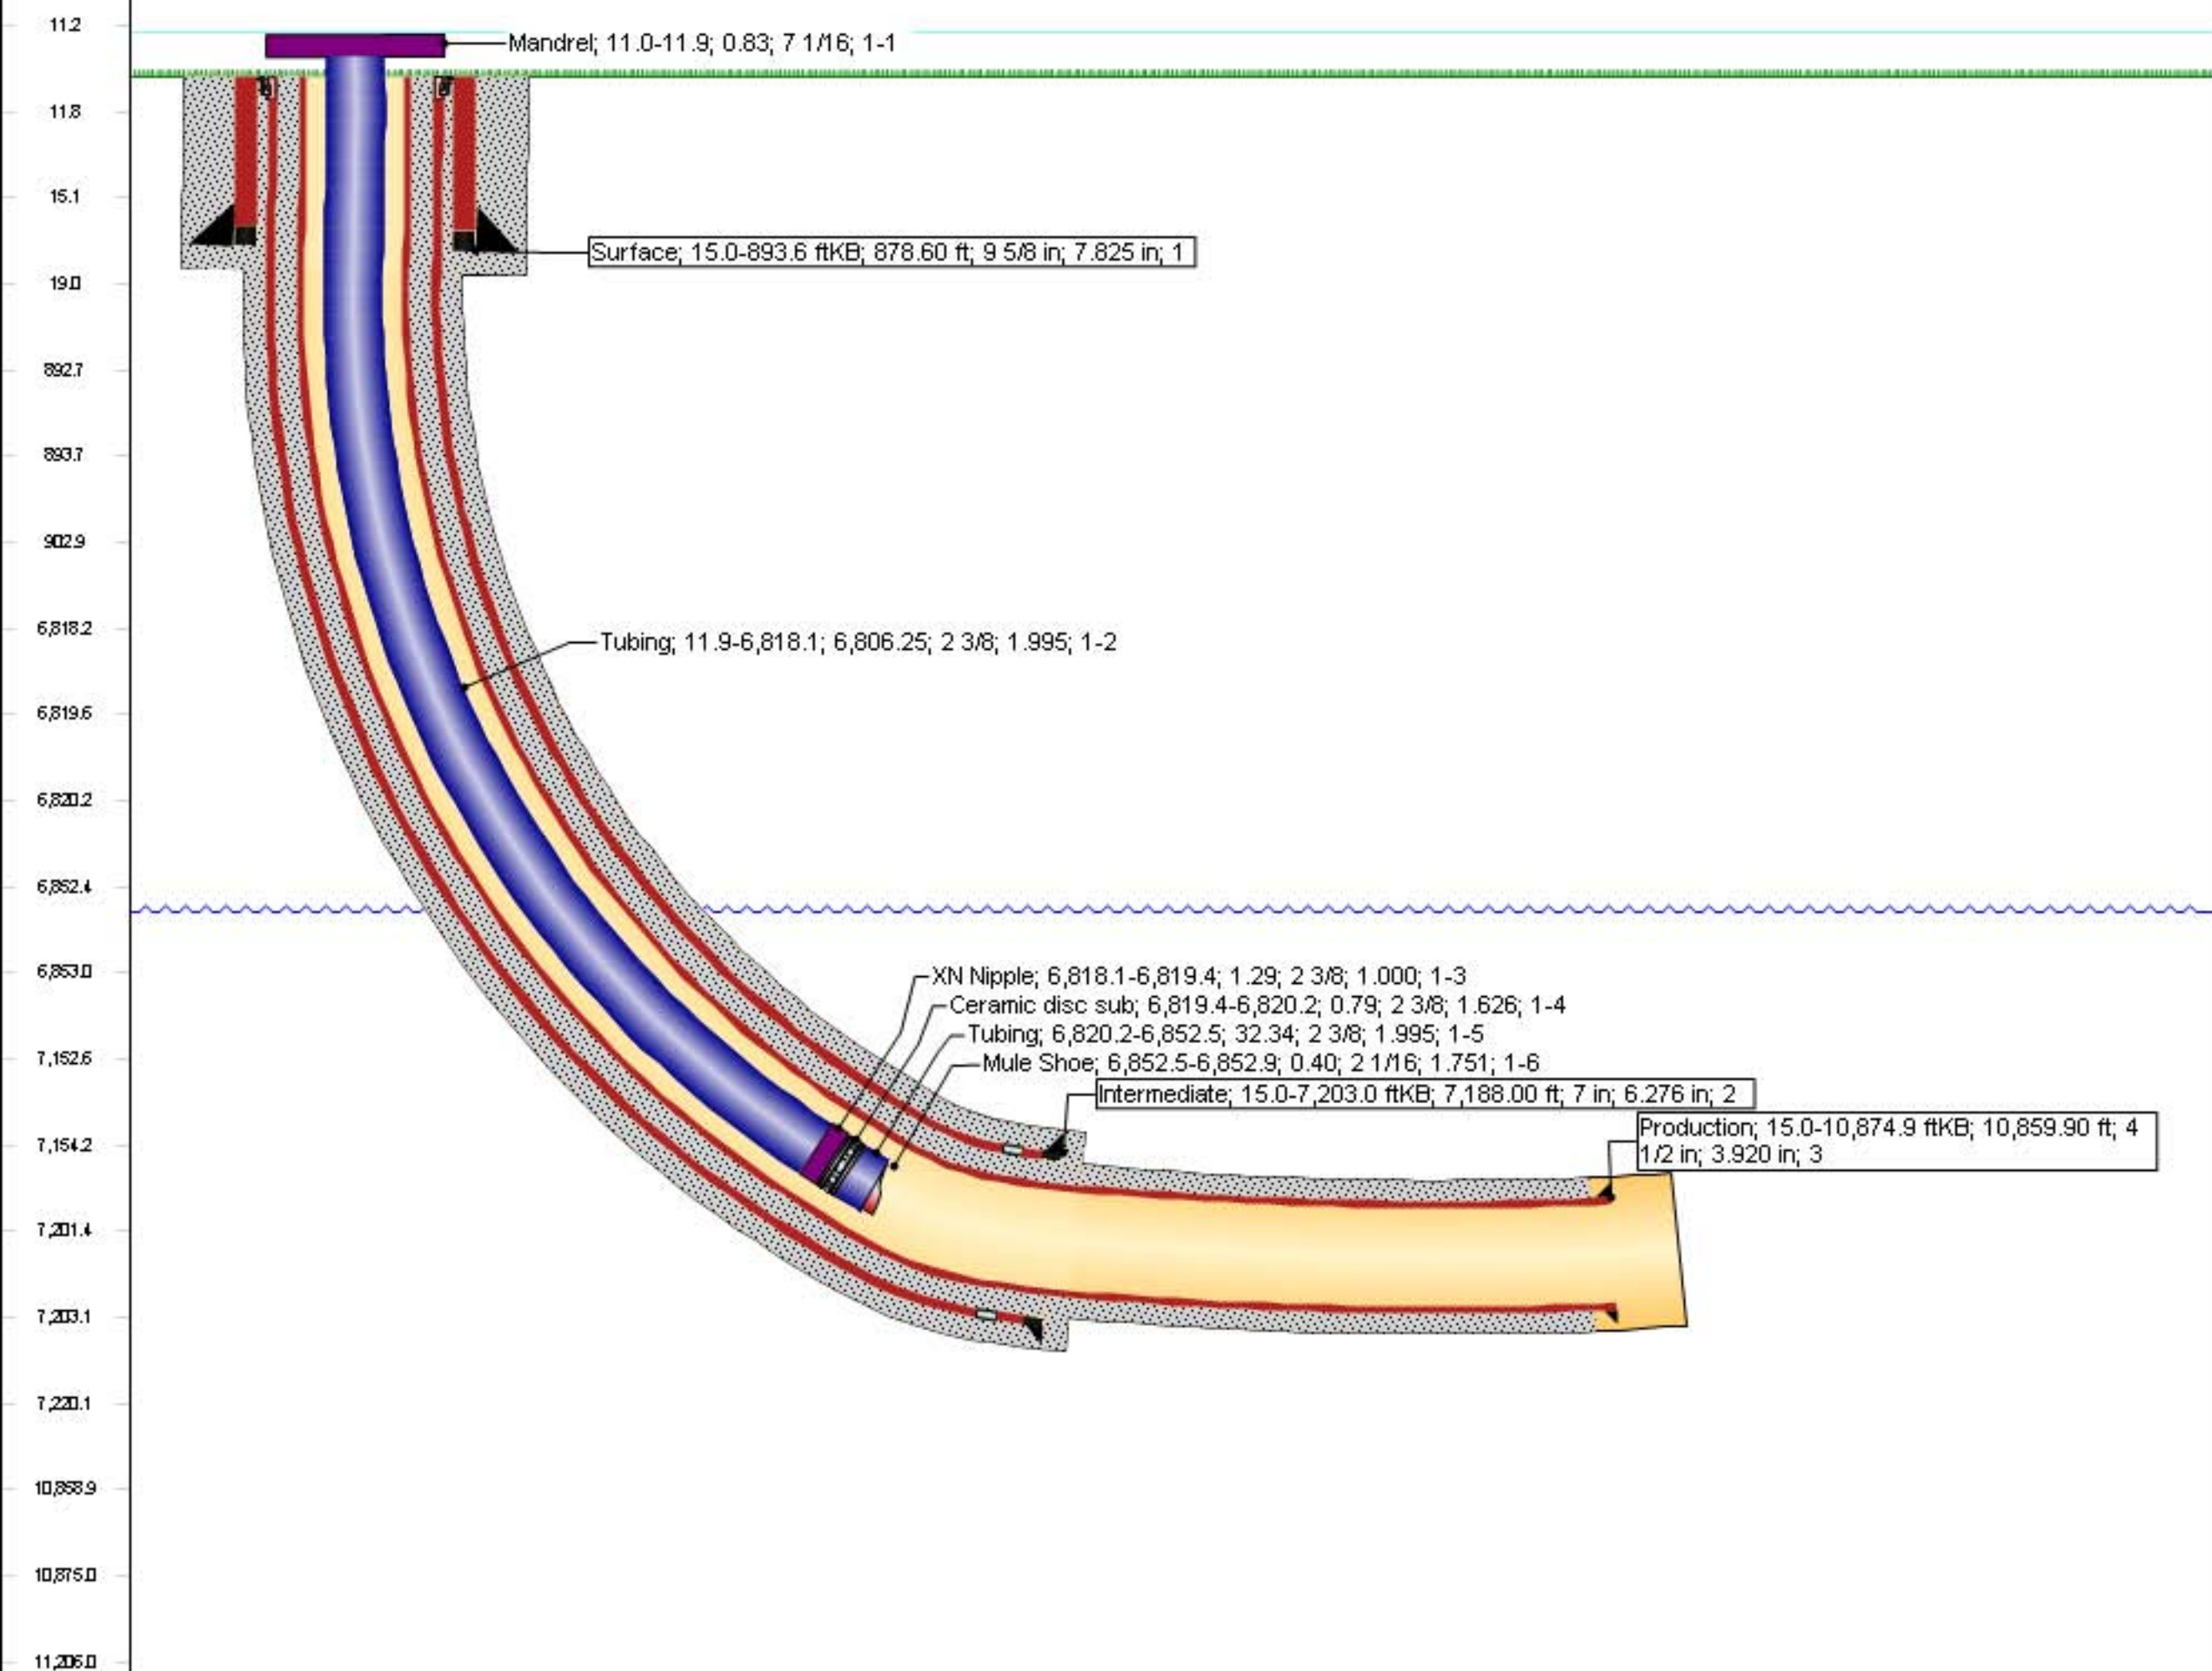

Note: Directional schematic does not correlate to other tracks.