

# J-W OPERATING COMPANY

P. O. BOX 305  
WRAY, COLORADO 80758-0305

PHONE 970 332-3151

OIL AND GAS PROPERTY MANAGEMENT

February 18, 1998

John Redmond  
PITCO  
918-747-4987 (fax)

RE: Pit closures

Dear John,

I have reviewed your invoice file and have found the following work has been performed on your wells by J-W Operating Company :

- 11-18-97: Hillman #1, Backfill water pit. # 109700
- 11-18-97: W. Korf #1, Backfill water pit.
- 11-18-97: Korf #2-25, Backfill water pit and hookup water drain to tank. # 109698
- 11-18-97: Hillman #2-25, Backfill water pit, hookup water drain to tank and repair line leak. #109698
- 11-19-97: Hillman #2-25, Repair 3" flowline leak.
- 11-25-97: Hillman #2-25, Dig up and attempt to repair water tank.
- 11-26-97 Hillman #2-25, Finish tank repair.
- 12-02-97 Hillman#1, Locate and dig up water leak, rebuild riser and backfill.

The Korf #3 has a small earthen (approx. 2 bbl.) catch pit beside the buried tank. If you want it backfilled please let me know. If you have questions or concerns, please call our Wray office.

Sincerely,



Jack Weaver

cc: KLR

W.Korf #01 Well File  
Korf #2-25 Well File  
Hillman #1 Well File  
Hillman #2-25 Well File  
Korf #3 Well File



DISPOSAL PIT INFORMATION

Date Insepcted: March 16, 1988

Well Name & No.: Hillman #1 109700


Legal Description: SE/4, SE/4, SE/4, Section 25, T5N, R47W

Pit Size: 10' x 10' x 4'

Nearest Water Source: one-quarter mile to the North (irrigation well)

Subsoil Type: Chalky Clay - mixed with gravel

DIAGRAM OF DISPOSAL PIT & SURROUNDING LOCATION:

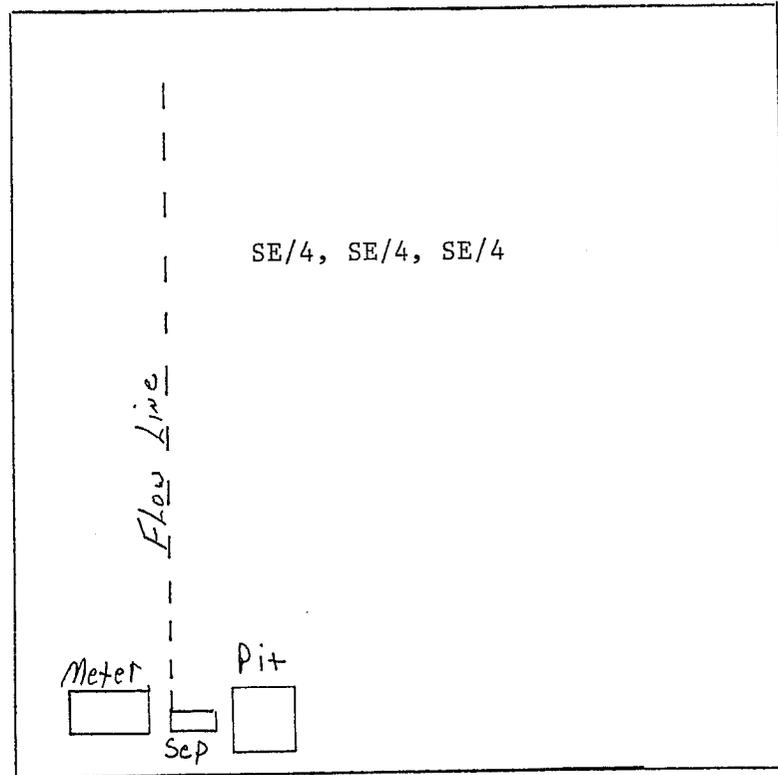

COMMENTS:

There is a 12" Brim around the pit.

\_\_\_\_\_

\_\_\_\_\_

\_\_\_\_\_

\_\_\_\_\_

Inspected By: Andy Baucke  
Andy Baucke



03/06/2014



NO MORE THAN 100 MIL CAPACITY

03/06/2014