
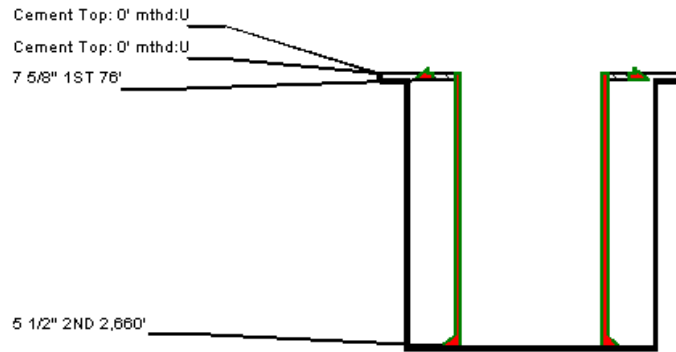


Well Completion Diagram

| | | | | | | |
|-------------------------------|------------------------|--------|--------------|------------|-------------------|-----------|
| API Well No: 05-103-05148-00- | | | | | | |
| Owner: | COASTAL OIL & GAS CORP | | | Well Name: | DRAGON TRAIL UNIT | |
| County: | RIO BLANCO | Field: | DRAGON TRAIL | Pool: | | |
| Coordinates: X | 1803 FWL | ; Y | 2041 FNL | Sec: 22 | Twp: 2S | Rng: 102W |

Note: Changes to the drawing do not effect the database

Bore Diameters (in.)

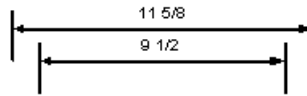

Total Vertical Depth 10,000'