
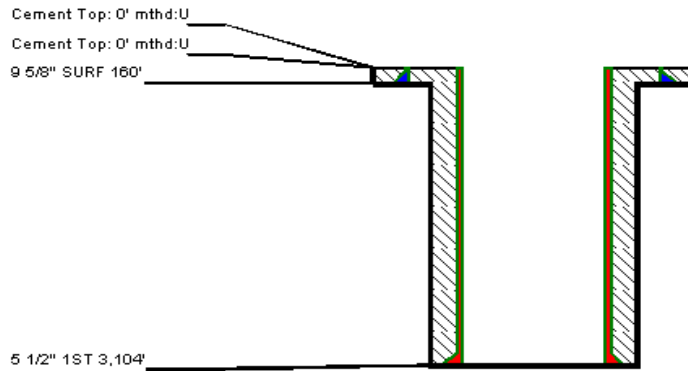


# Well Completion Diagram

<b>API Well No:</b> 05-103-09671-00-					
<b>Owner:</b>	COASTAL OIL & GAS CORP			<b>Well Name:</b>	SW RANGELY FED C
<b>County:</b>	RIO BLANCO	<b>Field:</b>	RANGELY-SOUTHWEST	<b>Pool:</b>	
<b>Coordinates: X</b>	1727 FEL	<b>Y</b>	923 FSL	<b>Sec:</b> 24	<b>Twp:</b> 1S <b>Rng:</b> 103W

Note: Changes to the drawing do not effect the database

Bore Diameters (in.)

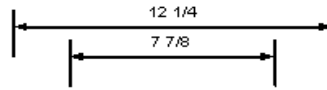

Total Vertical Depth 10,000'