


Hill Ranch 16-09VX
Sec 16, T35S, R67W
API#: 05-071-09275

GL: 7,824'
NO KB CORR

TOPS:
CASING SHOE 483'
Vermejo Coal 1,788'

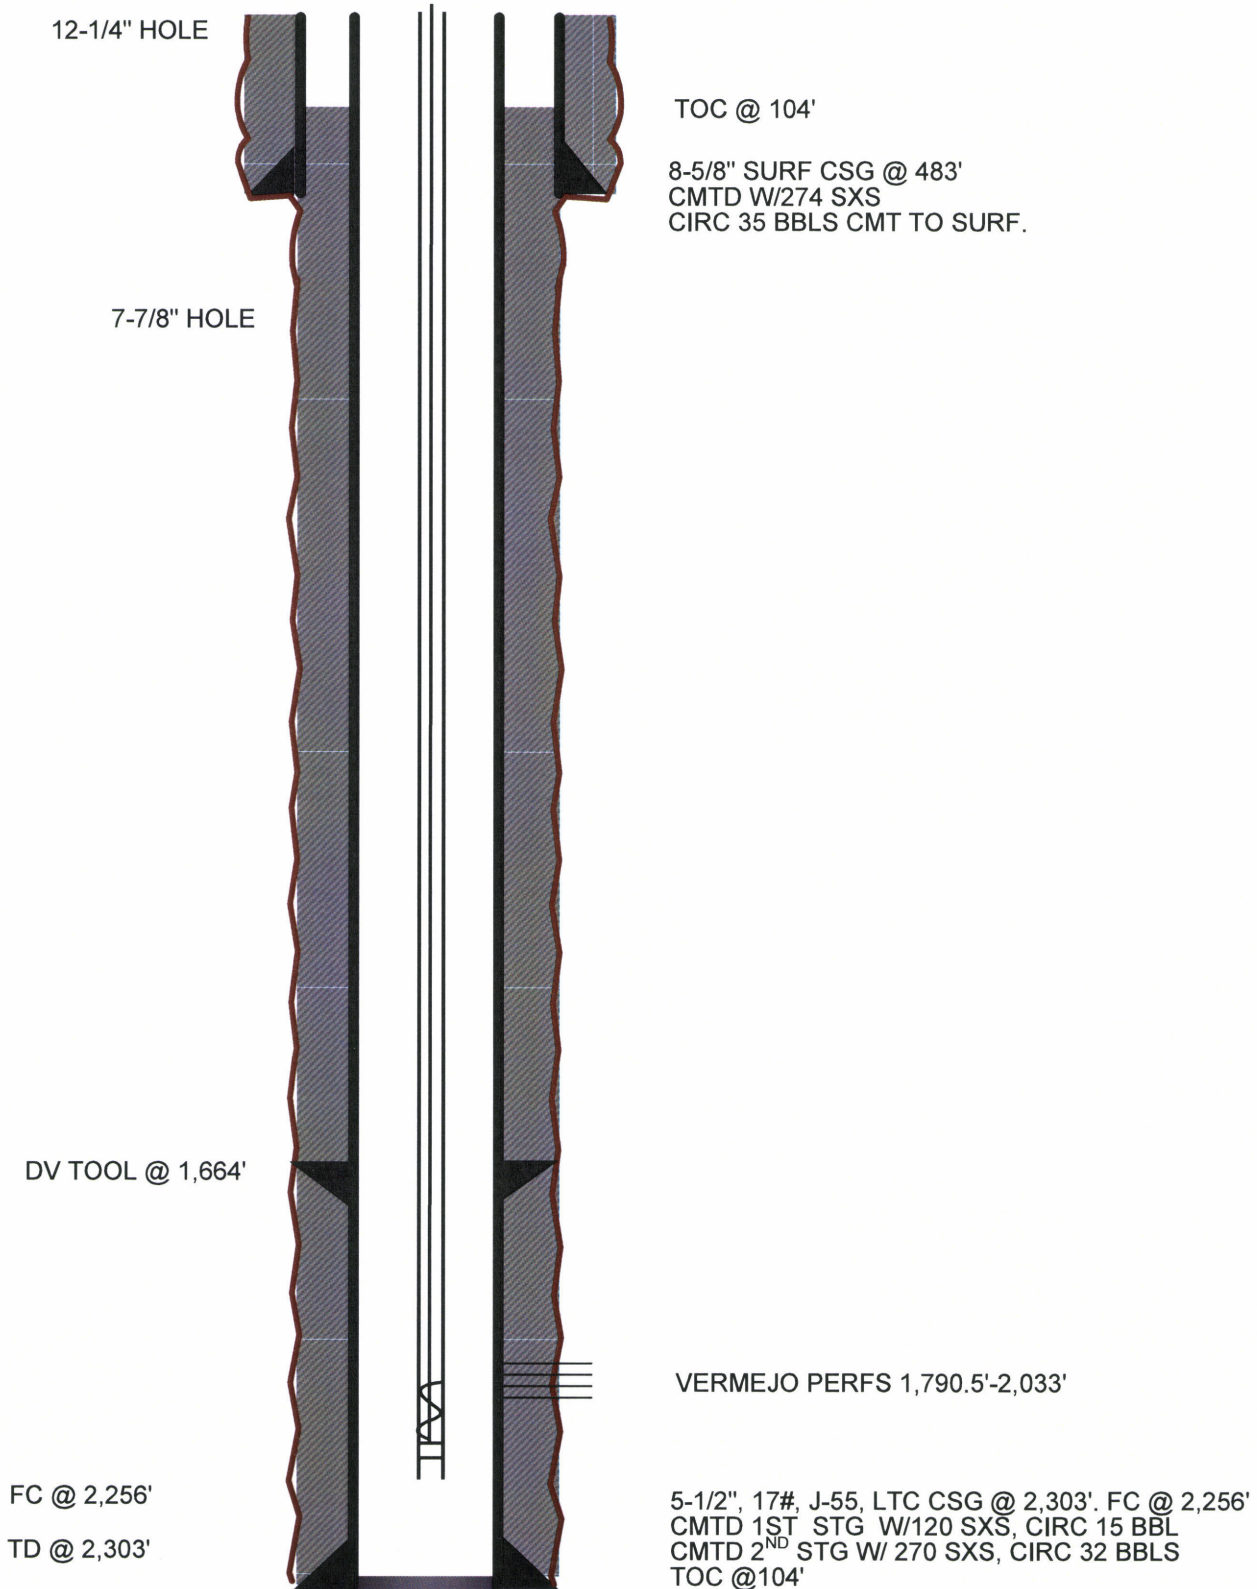

Hill Ranch 16-09VX
Sec 16, T35S, R67W
API#: 05-071-09275

GL: 7,824'
NO KB CORR

TOPS:
CASING SHOE 483'
Vermejo Coal 1,788'

