


## Well Completion Diagram

API Well No: 05-075-06179-00-					
Owner:	CORAL PRODUCTION CORP			Well Name:	YENTER 41
County:	LOGAN	Field:	YENTER	Pool:	
Coordinates: X	2310 FEL	; Y	1067 FNL	Sec: 3	Twp: 8N Rng: 54W

Note: Changes to the drawing do not effect the database

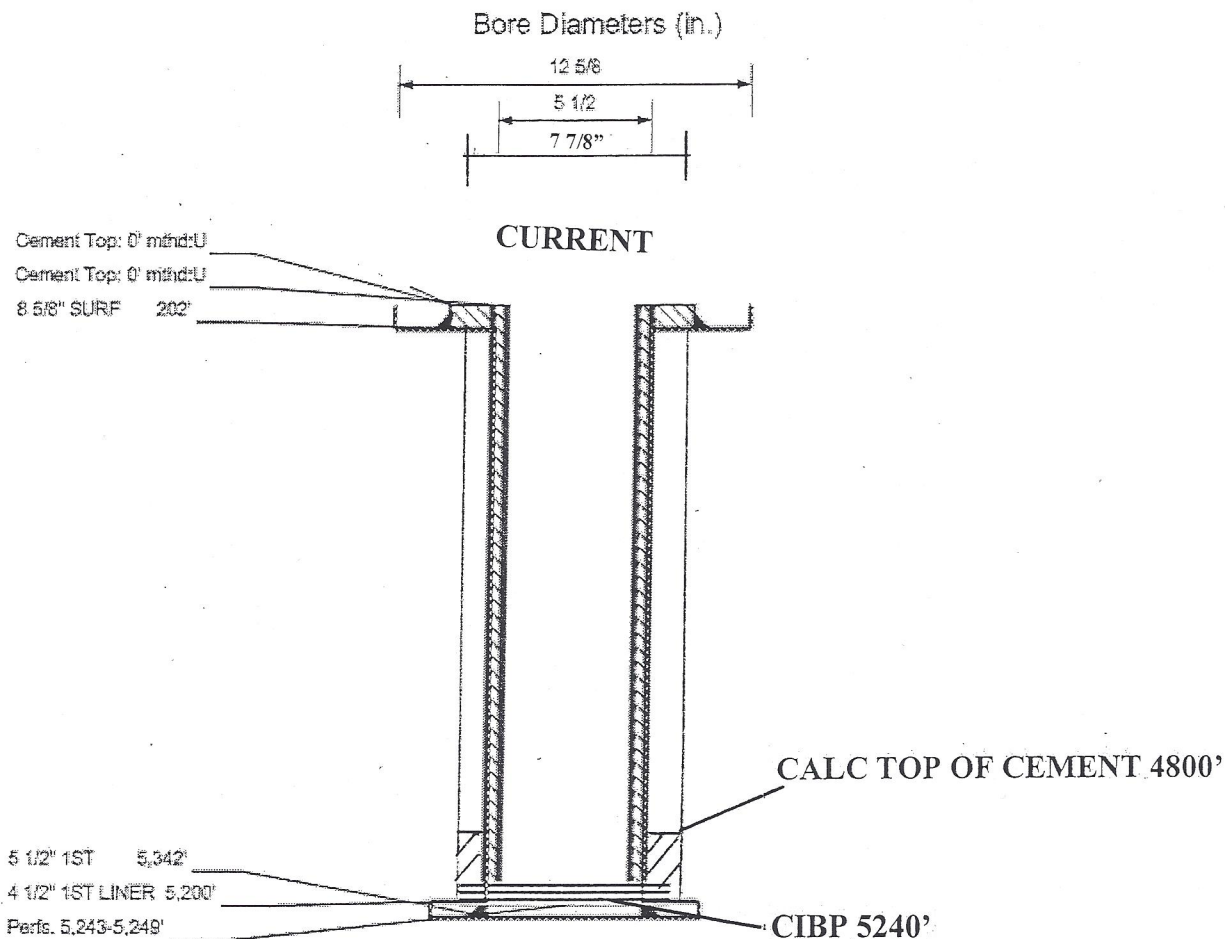

## Well Completion Diagram

API Well No: 05-075-06179-00-							
Owner:	CORAL PRODUCTION CORP			Well Name:	YENTER <i>AI</i>		
County:	LOGAN	Field:	YENTER	Pool:			
Coordinates: X	2310 FEL	Y	1067 FNL	Sec:	3	Twp:	8N Rng: 54W

Note: Changes to the drawing do not effect the database

