


Well Name: FEIT E23-16

VERTICAL - ORIGINAL HOLE, 3/13/2014 7:23:21 AM

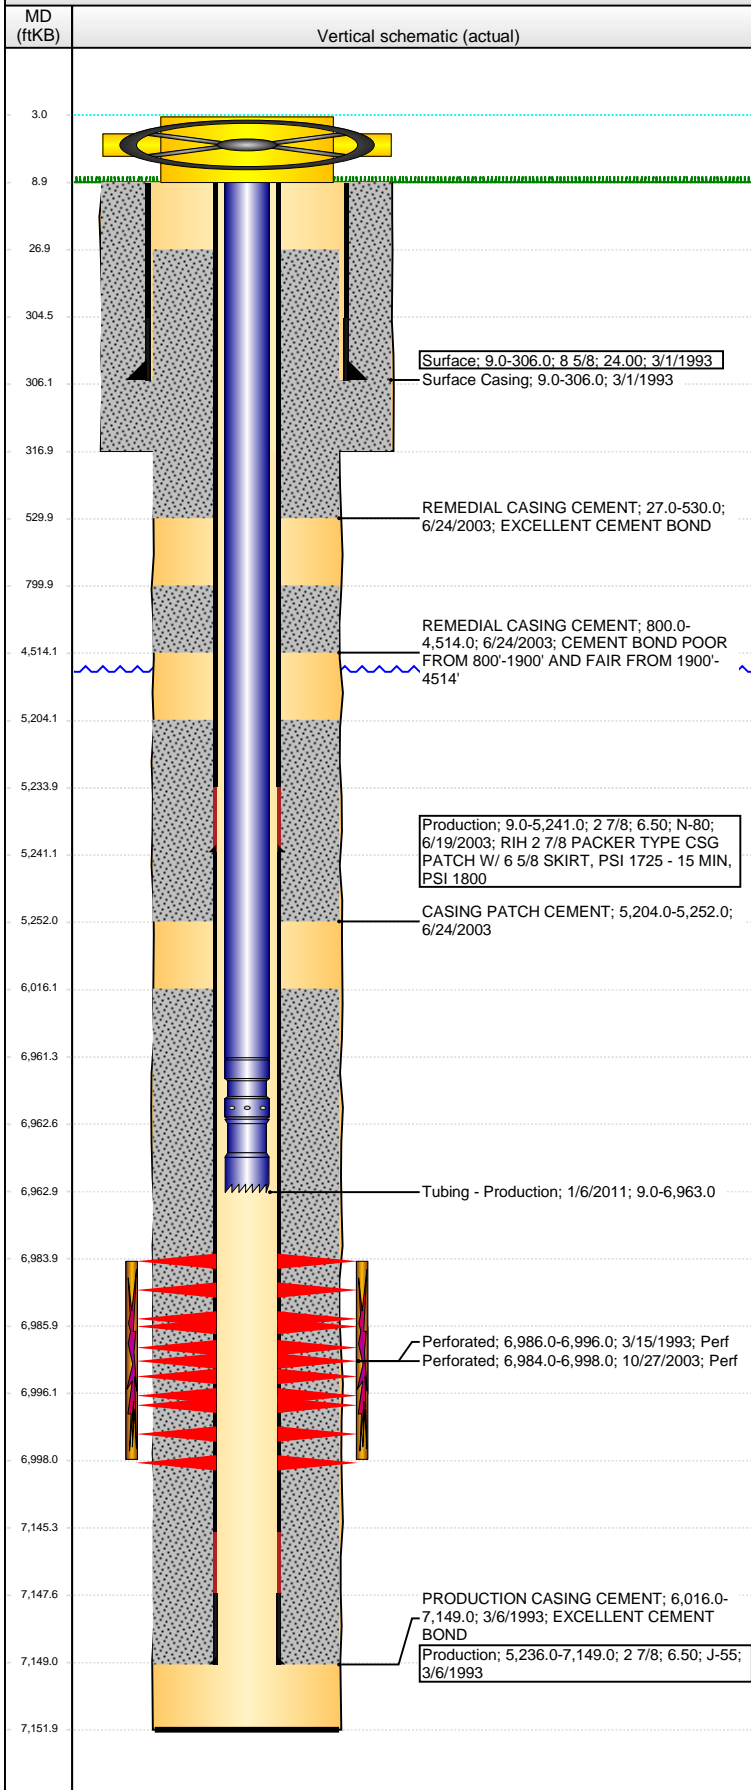

Well Header

API	Business Unit	District	Well Config
05-123-16796	WATTENBERG	15	VERTICAL
Original KB Elevation (ft)	KB - GL / MSL (ftKB)	Spud Date	P & A Date
4,703.00	9.00	3/1/1993	
Comment			
CSG RPR 6/03. PATCH @ 5241', TEST 5500#, 465 SX			
Directions To Well			

Congressional Location

Quarter 1	Quarter 2	Quarter 3	Quarter 4	Section	Township	Twnshp N...	Range	Rng E/W Dir
		SE	SE	23	6	N	65	W

Bottom Hole Location

North-South Distance (ft)	From N or S Line	East-West Distance (ft)	From E or W Line

Plug Back Total Depths

Date	Depth (ftKB)	Method	Com
6/17/2003	6,955.0	TAG	
7/10/2003	6,957.0	TAG	CO TO 7106
10/24/2003	6,989.0	TAG	CO TO 7136
11/10/2003	6,985.0	TAG	CO TO 6985
1/5/2011	7,152.0	TAG	LAST CLEANOUT

Wellbore Sections

Section Des	Size (in)	Act Top, MD (ftKB)	Act Btm, MD (ftKB)
SURFACE	12 1/4	9.0	317.0
PRODUCTION	7 7/8	317.0	7,152.0

Zone Statuses

Zone Name	Status Date	Status	Job
CODELL	5/4/1993	PR	DRILLING/COMPLETION - ORIGINAL, 3/1/1993 06:00
CODELL	11/11/2003	PR	RE-FRAC, 10/24/2003 06:00

Casing Strings

Casing Description	Run Date	OD (in)	Wt/Len (l...)	Grade	Top, MD (ft...)	MD (ftKB)
Surface	3/1/1993	8 5/8	24.00		9.0	306.0

Production, 5,241.0ftKB

Casing Description	Run Date	OD (in)	Wt/Len (l...)	Grade	Top, MD (ft...)	MD (ftKB)
Production	6/19/2003	2 7/8	6.50	N-80	9.0	5,241.0

Production, 7,149.0ftKB

Casing Description	Run Date	OD (in)	Wt/Len (l...)	Grade	Top, MD (ft...)	MD (ftKB)
Production	3/6/1993	2 7/8	6.50	J-55	9.0	7,149.0

Cement

Description	Top Depth (ftKB)	Bottom Depth (ftKB)
Surface Casing	9.0	306.0
PRODUCTION CASING CEMENT	6,016.0	7,149.0
REMEDIAL CASING CEMENT	27.0	530.0
REMEDIAL CASING CEMENT	800.0	4,514.0
CASING PATCH CEMENT	5,204.0	5,252.0

Tubing Components

Item Des	OD (in)	Wt (lb/ft)	Grade	Jts	Len (ft)	Btm (ftKB)	Btm (TVD) (ftKB)
Tubing	1.9	2.75	J-55	217	6,952.30	6,961.3	
Seal Nipple	1.9			1	1.20	6,962.5	
Notched collar	1.9				0.50	6,963.0	

Perforation Data

Zone	Bnch/St g	Entered Shot Total	Top (ftKB)	Btm (ftKB)	Date
CODELL, ORIGINAL HOLE		56	6,984.00	6,998.00	10/27/2003
CODELL, ORIGINAL HOLE		40	6,986.00	6,996.00	3/15/1993

Stimulations & Treatments

Date	Zone	Primary Job Type
3/20/1993	CODELL, ORIGINAL HOLE	DRILLING/COMPLETION - ORIGINAL
Technical Result	Tech Result Details	Tech Result Note
Comment		

Well Name: FEIT E23-16

VERTICAL - ORIGINAL HOLE, 3/13/2014 7:23:23 AM

Stimulations & Treatments

Date 11/4/2003	Zone CODELL, ORIGINAL HOLE	Primary Job Type RE-FRAC
Technical Result	Tech Result Details	Tech Result Note
Comment		

Other In Hole

Run Date	Des	OD (in)	Top (ftKB)	Btm (ftKB)

Logs

Date	Type	Top, MD (ftKB)	Btm, MD (ftKB)
3/6/1993	COMPENSATED DENSITY	3,200.0	7,118.0
3/6/1993	INDUCTION	306.0	7,143.0
3/15/1993	CBL/CCL/GR	5,920.0	7,100.0
7/2/2003	CBL/CCL/GR	0.0	4,600.0
12/30/2010	GYRO	0.0	6,980.0

