

## WELLBORE DIAGRAM


Bayswater E&P  
Matrix 11-29  
SEC 29 6N 65 W  
WELD  
CO

SHL 229' FNL 858' FWL NW NW  
BHL 692' FNL 708' FWL NW NW

10/25/2013  
BCB

05-123-29058

KB 4737  
GL 4725  
12

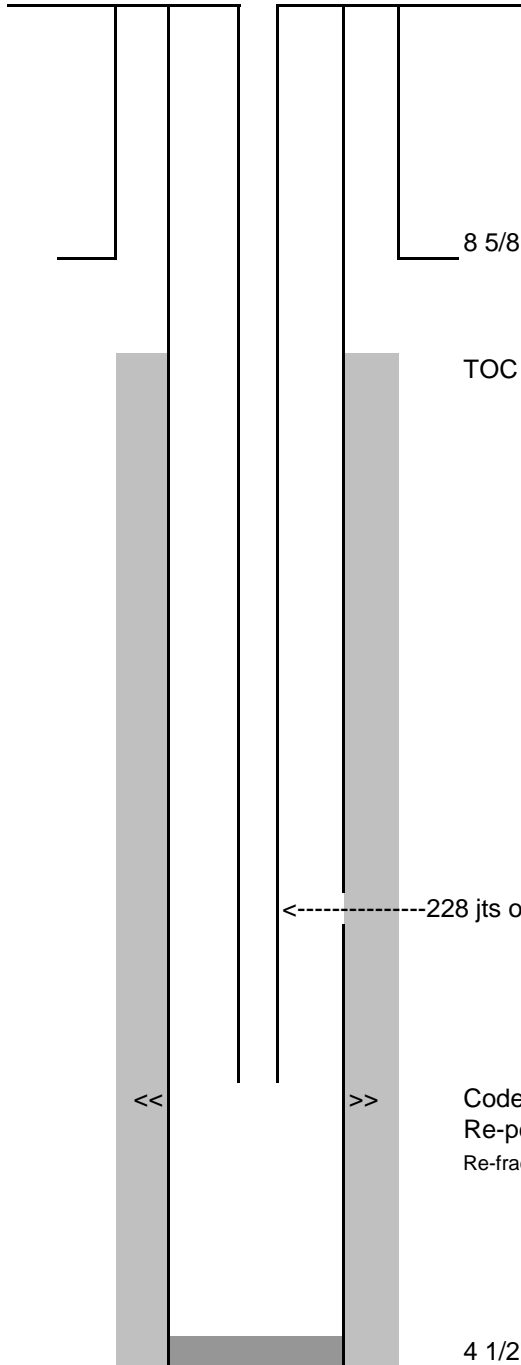

←-----228 jts of 2 3/8" 4.7# EUE 8rd tbg - meas - 7164.60', SN@ 7196.00'

Codell: 7212' - 7224', 3 SPF SLK Gun  
Re-perf'd 10/20/13, 7212'-7226', 4 spf  
Re-frac Codell 3,139 bbls 24# XL CMHPG & 179,005# 20/40 sand.

4 1/2", 11.6#, x-xx, LTC xxxx' w/ xxx sx 50/50 poz

PBTD 7271  
TD MD 7357  
TD TVD 7304