

Project: Weld County, CO (NAD 83)
 Site: Sec. 20-T6N-R62W (Wells Ranch AE PAD)
 Well: Wells Ranch AE20-65HN
 Wellbore: Plan A
 Design: Final Surveys

Noble Energy





Platted SHL: 1831' FSL, 215' FWL
 Platted Lat/Long: 40.46999° N, 104.35531° W
 Location: Sec. 20-T6N-R62W

7" Casing: ~2579.68' FNL, ~817.75' FWL
 Lat/Long: 40° 28' 20.867 N, 104° 21' 11.146 W
 State Planes - CO Northern: 1,417,022.13' N, 3,319,074.31' E
 Location: Sec. 20-T6N-R62W

BHL: ~2645.03' FNL, ~534.74' FEL
 Lat/Long: 40° 28' 20.844 N, 104° 20' 21.201 W
 State Planes - CO Northern: 1,417,070.02' N, 3,322,933.82' E
 Location: Sec. 20-T6N-R62W

LEGEND

- Wells Ranch AE20-65HN, Plan A, Rev A0 V0
- Final Surveys

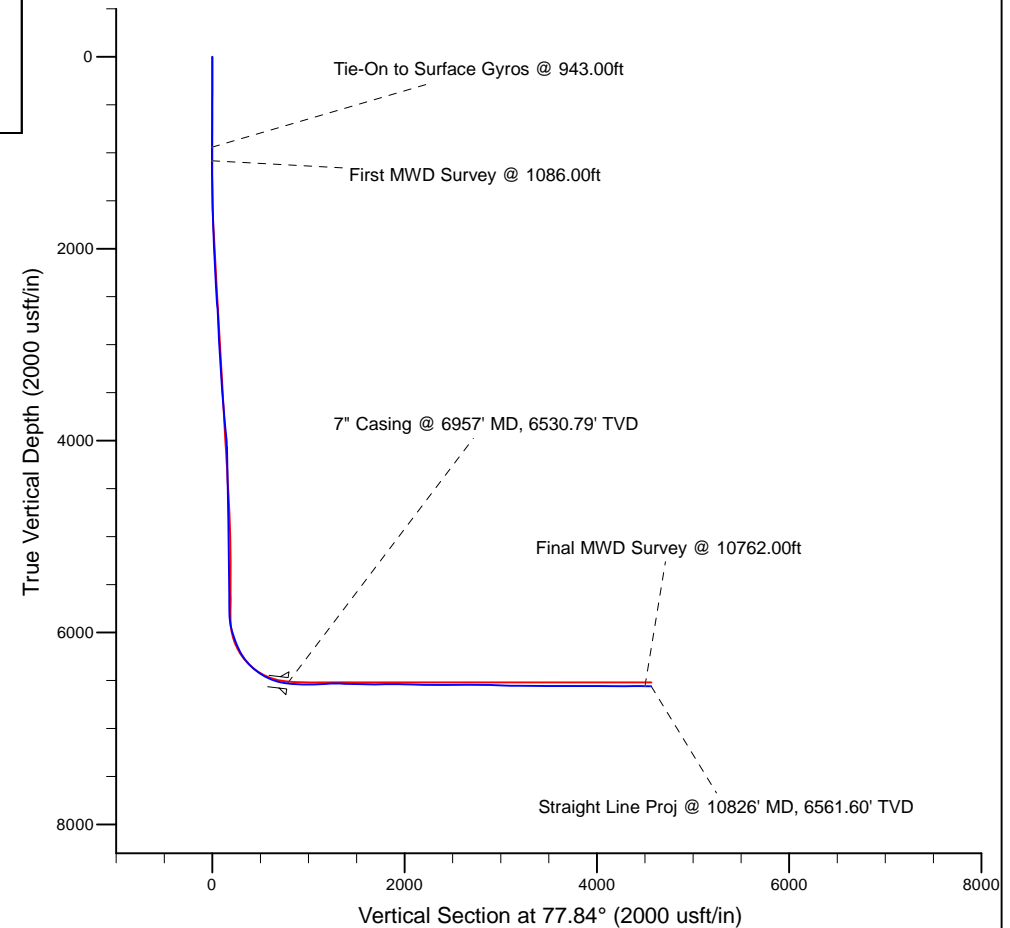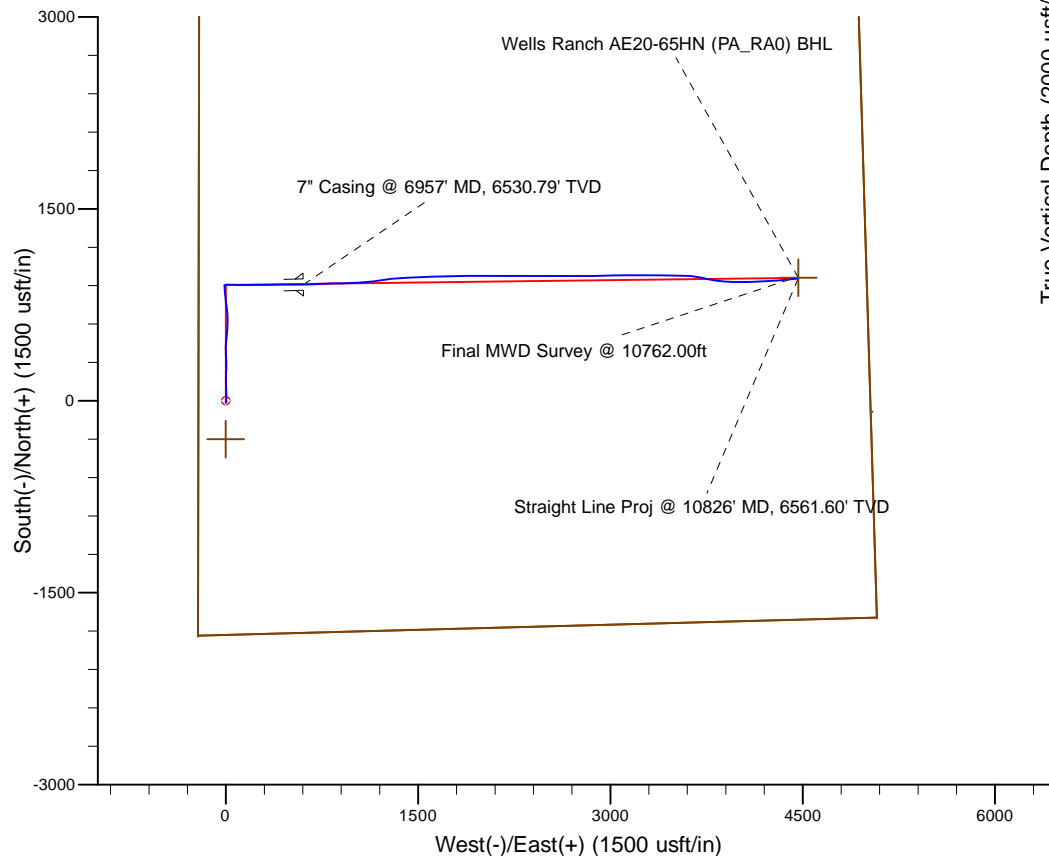

WELL DETAILS: Wells Ranch AE20-65HN

Ground Level: 4785.00
 RKB 24 ft. @ 4809.00usft (H&P 343)

Created By: Fred Hartmann
 Created On: 11/14/2013

Noble Energy

Weld County, CO (NAD 83)

Sec. 20-T6N-R62W (Wells Ranch AE PAD)

Wells Ranch AE20-65HN - A9

Design: Final Surveys

Sperry Drilling Services

Final Survey Report

14 November, 2013

Well Coordinates: 1,416,113.31 N, 3,318,470.04 E (40° 28' 11.96" N, 104° 21' 19.12" W)

Ground Level: 4,785.00 usft

Local Coordinate Origin:

Centered on Well Wells Ranch AE20-65HN - Slot A9

Viewing Datum:

RKB 24 ft. @ 4809.00usft (H&P 343)

TVDs to System:

N

North Reference:

Grid

Unit System:

API - US Survey Feet - Custom

Geodetic Scale Factor Applied

Version: 5000.1 Build: 70

HALLIBURTON

Design Report for Wells Ranch AE20-65HN - Final Surveys

Measured Depth (usft)	Inclination (°)	Azimuth (°)	Vertical Depth (usft)	+N/-S (usft)	+E/-W (usft)	Vertical Section (usft)	Dogleg Rate (°/100usft)
0.00	0.00	0.00	0.00	0.00	0.00	0.00	0.00
352.00	0.10	353.02	352.00	0.30	-0.04	0.03	0.03
631.00	1.60	190.82	630.97	-3.28	-0.80	-1.47	0.61
943.00	1.00	175.82	942.88	-10.27	-1.42	-3.55	0.22
Tie-On to Surface Gyros @ 943.00ft							
1,086.00	1.05	152.00	1,085.86	-12.67	-0.71	-3.36	0.30
First MWD Survey @ 1086.00ft							
1,179.00	1.29	206.16	1,178.85	-14.37	-0.77	-3.78	1.17
1,272.00	0.95	67.52	1,271.84	-15.01	-0.52	-3.67	2.26
1,364.00	2.52	31.33	1,363.79	-12.99	1.23	-1.53	2.00
1,457.00	4.33	7.57	1,456.63	-7.76	2.76	1.06	2.43
1,552.00	6.94	2.60	1,551.16	1.53	3.49	3.74	2.79
1,647.00	8.61	354.64	1,645.29	14.34	3.09	6.04	2.09
1,742.00	8.89	1.38	1,739.19	28.76	2.60	8.60	1.12
1,837.00	10.13	2.18	1,832.88	44.45	3.10	12.39	1.31
1,931.00	12.00	359.65	1,925.13	62.48	3.35	16.43	2.05
2,026.00	13.07	355.38	2,017.86	83.06	2.43	19.86	1.49
2,121.00	13.39	359.83	2,110.34	104.77	1.53	23.55	1.12
2,216.00	14.95	0.59	2,202.45	128.03	1.62	28.54	1.65
2,311.00	15.15	359.42	2,294.19	152.69	1.62	33.74	0.38
2,406.00	14.99	359.38	2,385.93	177.39	1.36	38.68	0.17
2,501.00	15.23	359.31	2,477.64	202.15	1.08	43.62	0.25
2,596.00	17.16	3.03	2,568.87	228.63	1.67	49.77	2.31
2,691.00	14.84	1.50	2,660.18	254.79	2.73	56.32	2.48
2,786.00	15.68	359.75	2,751.83	279.79	2.99	61.84	1.01
2,881.00	16.39	357.61	2,843.14	306.02	2.38	66.76	0.97
2,976.00	15.79	358.12	2,934.42	332.33	1.39	71.34	0.65
3,071.00	14.07	357.66	3,026.21	356.79	0.50	75.61	1.81
3,166.00	14.97	359.01	3,118.17	380.59	-0.18	79.96	1.01
3,261.00	14.67	2.24	3,210.01	404.88	0.07	85.32	0.93
3,356.00	14.07	359.26	3,302.04	428.45	0.39	90.60	1.00
3,451.00	13.37	3.83	3,394.33	450.96	0.98	95.91	1.36
3,545.00	13.61	5.23	3,485.74	472.81	2.71	102.21	0.43
3,640.00	15.77	5.66	3,577.63	496.79	5.01	109.50	2.28
3,735.00	18.16	4.20	3,668.49	524.41	7.36	117.62	2.56
3,830.00	19.61	3.89	3,758.37	555.08	9.53	126.19	1.53
3,925.00	21.80	4.39	3,847.23	588.58	11.96	135.62	2.31
4,020.00	20.15	0.71	3,935.94	622.53	13.51	144.29	2.22
4,115.00	17.37	358.13	4,025.88	653.07	13.25	150.47	3.05
4,210.00	14.00	354.38	4,117.33	678.69	11.67	154.31	3.70
4,305.00	11.02	354.80	4,210.07	699.17	9.72	156.72	3.14
4,399.00	11.45	352.80	4,302.27	717.38	7.73	158.61	0.62
4,494.00	12.93	353.11	4,395.12	737.28	5.28	160.40	1.56
4,589.00	10.78	347.64	4,488.09	756.52	2.10	161.34	2.55
4,684.00	8.94	358.55	4,581.69	772.58	0.01	162.68	2.75
4,779.00	7.66	353.09	4,675.70	786.24	-0.94	164.63	1.58
4,874.00	7.28	351.47	4,769.89	798.48	-2.59	165.59	0.46
4,969.00	7.04	355.03	4,864.15	810.23	-3.99	166.70	0.53
5,061.00	7.30	352.59	4,955.43	821.65	-5.23	167.89	0.44
5,156.00	8.04	356.65	5,049.58	834.26	-6.40	169.41	0.97

Design Report for Wells Ranch AE20-65HN - Final Surveys

Measured Depth (usft)	Inclination (°)	Azimuth (°)	Vertical Depth (usft)	+N/-S (usft)	+E/-W (usft)	Vertical Section (usft)	Dogleg Rate (°/100usft)
5,251.00	7.36	354.93	5,143.73	846.96	-7.32	171.17	0.76
5,346.00	6.60	354.58	5,238.02	858.45	-8.38	172.57	0.80
5,440.00	7.58	356.44	5,331.30	870.02	-9.27	174.13	1.07
5,535.00	6.08	355.39	5,425.62	881.29	-10.07	175.72	1.58
5,630.00	5.09	355.83	5,520.17	890.51	-10.78	176.97	1.04
5,725.00	3.21	346.81	5,614.92	897.30	-11.69	177.51	2.09
5,820.00	1.87	357.77	5,709.82	901.44	-12.36	177.73	1.49
5,915.00	2.22	23.36	5,804.77	904.68	-11.69	179.06	1.02
6,010.00	7.54	82.73	5,899.43	907.16	-4.77	186.35	7.04
6,057.00	13.79	87.85	5,945.59	907.76	3.90	194.95	13.44
6,105.00	16.26	90.01	5,991.95	907.97	16.33	207.15	5.28
6,152.00	18.74	90.13	6,036.77	907.95	30.47	220.96	5.28
6,200.00	20.65	91.37	6,081.96	907.73	46.64	236.73	4.07
6,247.00	23.25	91.69	6,125.55	907.26	64.20	253.79	5.54
6,295.00	26.35	91.44	6,169.12	906.72	84.32	273.35	6.46
6,342.00	29.84	90.88	6,210.57	906.27	106.45	294.89	7.45
6,390.00	33.77	89.57	6,251.36	906.19	131.74	319.60	8.31
6,437.00	37.71	89.51	6,289.50	906.41	159.19	346.47	8.38
6,485.00	42.85	88.98	6,326.11	906.83	190.21	376.89	10.73
6,532.00	48.11	89.35	6,359.05	907.31	223.70	409.73	11.21
6,579.00	51.93	90.04	6,389.24	907.50	259.71	444.97	8.21
6,626.00	55.23	89.98	6,417.14	907.49	297.53	481.94	7.02
6,674.00	58.77	90.07	6,443.28	907.47	337.78	521.28	7.38
6,721.00	63.28	88.87	6,466.04	907.86	378.88	561.54	9.85
6,769.00	66.94	88.91	6,486.24	908.70	422.41	604.27	7.63
6,816.00	72.01	90.64	6,502.72	908.87	466.41	647.32	11.32
6,864.00	76.41	90.70	6,515.78	908.33	512.58	692.35	9.17
6,912.00	81.75	89.58	6,524.87	908.22	559.69	738.38	11.36
6,957.00	83.11	88.78	6,530.79	908.86	604.29	782.12	3.50
7" Casing @ 6957' MD, 6530.79' TVD							
7,039.00	85.59	87.32	6,538.87	911.64	685.84	862.42	3.50
7,134.00	89.26	88.10	6,543.13	915.43	780.65	955.90	3.95
7,229.00	91.42	88.57	6,542.57	918.19	875.60	1,049.31	2.33
7,324.00	93.67	87.23	6,538.35	921.66	970.44	1,142.75	2.76
7,419.00	92.72	86.65	6,533.06	926.73	1,065.15	1,236.41	1.17
7,514.00	87.84	82.50	6,532.59	935.71	1,159.68	1,330.70	6.74
7,609.00	88.92	81.43	6,535.28	948.98	1,253.70	1,425.41	1.60
7,704.00	86.89	86.77	6,538.75	958.74	1,348.10	1,519.75	6.01
7,799.00	89.51	86.43	6,541.74	964.37	1,442.88	1,613.59	2.78
7,894.00	90.80	87.86	6,541.48	969.10	1,537.75	1,707.33	2.03
7,989.00	91.20	89.16	6,539.82	971.57	1,632.70	1,800.67	1.43
8,084.00	89.97	88.80	6,538.85	973.26	1,727.68	1,893.88	1.35
8,179.00	88.49	88.12	6,540.13	975.81	1,822.64	1,987.24	1.71
8,274.00	88.95	89.64	6,542.25	977.67	1,917.59	2,080.46	1.67
8,369.00	88.55	90.86	6,544.32	977.26	2,012.57	2,173.22	1.35
8,464.00	89.11	89.99	6,546.26	976.55	2,107.54	2,265.92	1.09
8,559.00	89.57	90.49	6,547.36	976.15	2,202.53	2,358.69	0.72
8,654.00	90.77	89.59	6,547.08	976.09	2,297.53	2,451.55	1.58
8,749.00	90.56	89.66	6,545.97	976.71	2,392.52	2,544.54	0.23
8,843.00	90.86	90.54	6,544.81	976.54	2,486.51	2,636.39	0.99
8,938.00	89.41	89.69	6,544.59	976.35	2,581.51	2,729.22	1.77

Design Report for Wells Ranch AE20-65HN - Final Surveys

Measured Depth (usft)	Inclination (°)	Azimuth (°)	Vertical Depth (usft)	+N/-S (usft)	+E/-W (usft)	Vertical Section (usft)	Dogleg Rate (°/100usft)
9,033.00	88.00	90.83	6,546.73	975.92	2,676.48	2,821.97	1.91
9,128.00	88.06	90.05	6,550.00	975.19	2,771.42	2,914.63	0.82
9,223.00	88.77	89.07	6,552.63	975.92	2,866.38	3,007.61	1.27
9,318.00	89.23	87.51	6,554.28	978.76	2,961.32	3,101.02	1.71
9,413.00	88.71	89.77	6,555.99	981.01	3,056.27	3,194.32	2.44
9,508.00	89.54	88.76	6,557.44	982.23	3,151.25	3,287.42	1.38
9,603.00	89.54	90.58	6,558.21	982.78	3,246.24	3,380.40	1.92
9,698.00	89.88	90.03	6,558.69	982.27	3,341.24	3,473.16	0.68
9,793.00	91.45	91.63	6,557.58	980.90	3,436.22	3,565.72	2.36
9,888.00	89.04	90.68	6,557.18	978.98	3,531.19	3,658.16	2.73
9,983.00	89.23	92.89	6,558.61	976.02	3,626.13	3,750.34	2.33
10,078.00	91.29	105.90	6,558.18	960.55	3,719.64	3,838.51	13.86
10,172.00	89.48	97.92	6,557.55	941.17	3,811.54	3,924.26	8.70
10,267.00	89.01	92.88	6,558.80	932.23	3,906.08	4,014.80	5.33
10,362.00	89.32	90.18	6,560.18	929.70	4,001.03	4,107.09	2.86
10,457.00	89.54	88.86	6,561.13	930.49	4,096.02	4,200.11	1.41
10,552.00	90.71	86.73	6,560.92	934.15	4,190.94	4,293.68	2.56
10,647.00	90.49	86.00	6,559.93	940.17	4,285.74	4,387.62	0.80
10,762.00	88.98	84.06	6,560.46	950.13	4,400.30	4,501.71	2.14
Final MWD Survey @ 10762.00ft							
10,826.00	88.98	84.06	6,561.60	956.75	4,463.95	4,565.32	0.00
Straight Line Proj @ 10826' MD, 6561.60' TVD							

Design Annotations

Measured Depth (usft)	Vertical Depth (usft)	Local Coordinates		Comment
		+N/-S (usft)	+E/-W (usft)	
943.00	942.88	-10.27	-1.42	Tie-On to Surface Gyros @ 943.00ft
1,086.00	1,085.86	-12.67	-0.71	First MWD Survey @ 1086.00ft
10,762.00	6,560.46	950.13	4,400.30	Final MWD Survey @ 10762.00ft
10,826.00	6,561.60	956.75	4,463.95	Straight Line Proj @ 10826' MD, 6561.60' TVD

Vertical Section Information

Angle Type	Target	Azimuth (°)	Origin Type	Origin		Start TVD (usft)
				+N/_S (usft)	+E/-W (usft)	
Target	Wells Ranch AE20-65HN (PA_RA0) BHL	77.84	Slot	0.00	0.00	0.00

Survey tool program

From (usft)	To (usft)	Survey/Plan	Survey Tool
352.00	943.00	Surface Gyros	Flexi-Shot
1,086.00	6,912.00	MWD Surveys - Vert/Build	MWD+IFR1+MS_WY
7,039.00	10,762.00	MWD Surveys - Lateral	MWD+IFR1+MS_WY

Casing Details

Measured Depth (usft)	Vertical Depth (usft)	Name	Casing Diameter (")	Hole Diameter (")
6,957.00	6,530.79	7" Casing @ 6957' MD, 6530.79' TVD	7	8-3/4

Design Report for Wells Ranch AE20-65HN - Final Surveys

Wellbore Targets

Target Name - hit/miss target - Shape	Dip Angle (°)	Dip Dir. (°)	TVD (usft)	+N/-S (usft)	+E/-W (usft)	Northing (usft)	Easting (usft)	Latitude	Longitude
Wells Ranch AE (SL) F	0.00	0.00	0.00	-298.79	-1.71	1,415,814.53	3,318,468.33	40° 28' 9.012 N	104° 21' 19.188 W
- actual wellpath misses target center by 298.79usft at 0.00usft MD (0.00 TVD, 0.00 N, 0.00 E)									
- Polygon									
Point 1				0.00	-1,536.69	-216.70	1,414,277.89	3,318,251.63	
Point 2				0.00	-1,394.93	5,079.85	1,414,419.65	3,323,547.99	
Point 3				0.00	3,915.17	4,921.18	1,419,729.56	3,323,389.33	
Point 4				0.00	3,764.67	-207.18	1,419,579.06	3,318,261.15	
Point 5				0.00	-1,536.69	-216.70	1,414,277.89	3,318,251.63	
Wells Ranch AE20-65H	0.00	0.00	0.00	0.00	0.00	1,416,113.31	3,318,470.04	40° 28' 11.964 N	104° 21' 19.116 W
- actual wellpath hits target center									
- Point									
Wells Ranch AE (SB) F	0.00	0.00	0.00	-298.79	-1.71	1,415,814.53	3,318,468.33	40° 28' 9.012 N	104° 21' 19.188 W
- actual wellpath misses target center by 298.79usft at 0.00usft MD (0.00 TVD, 0.00 N, 0.00 E)									
- Polygon									
Point 1				0.00	-1,064.69	243.30	1,414,749.87	3,318,711.62	
Point 2				0.00	-945.93	4,607.35	1,414,868.63	3,323,075.51	
Point 3				0.00	3,443.17	4,474.83	1,419,257.57	3,322,943.00	
Point 4				0.00	3,319.17	251.02	1,419,133.58	3,318,719.34	
Point 5				0.00	-1,064.69	243.30	1,414,749.87	3,318,711.62	
Wells Ranch AE20-65H	0.00	0.00	6,520.00	961.62	4,464.56	1,417,074.89	3,322,934.43	40° 28' 20.892 N	104° 20' 21.192 W
- actual wellpath misses target center by 41.89usft at 10826.00usft MD (6561.60 TVD, 956.75 N, 4463.95 E)									
- Point									

Directional Difficulty Index

Average Dogleg over Survey:	2.39 °/100usft	Maximum Dogleg over Survey:	13.86 °/100usft at 10,078.00 usft
Net Tortousity applicable to Plans:	1.28 °/100usft	Directional Difficulty Index:	6.365

Audit Info

North Reference Sheet for Sec. 20-T6N-R62W (Wells Ranch AE PAD) - Wells Ranch AE20-65HN

All data is in US Feet unless otherwise stated. Directions and Coordinates are relative to Grid North Reference.

Vertical Depths are relative to RKB 24 ft. @ 4809.00usft (H&P 343). Northing and Easting are relative to Wells Ranch AE 20-65HN - Slot A9

Coordinate System is US State Plane 1983, Colorado Northern Zone using datum North American Datum 1983, ellipsoid GRS 1980

Projection method is Lambert Conformal Conic (2 parallel)

Central Meridian is 105° 30' 0.000 W°, Longitude Origin:0° 0' 0.000 E°, Latitude Origin:40° 47' 0.000 N°

False Easting: 3,000,000.00usft, False Northing: 1,000,000.00usft, Scale Reduction: 0.99996415


Grid Coordinates of Well: 1,416,113.31 usft N, 3,318,470.04 usft E

Geographical Coordinates of Well: 40° 28' 11.96" N, 104° 21' 19.12" W

Grid Convergence at Surface is: 0.74°

Based upon Minimum Curvature type calculations, at a Measured Depth of 10,826.00usft the Bottom Hole Displacement is 4,565.33usft in the Direction of 77.90° (Grid).

Magnetic Convergence at surface is: -7.64° (30 August 2013, , BGGM2013)

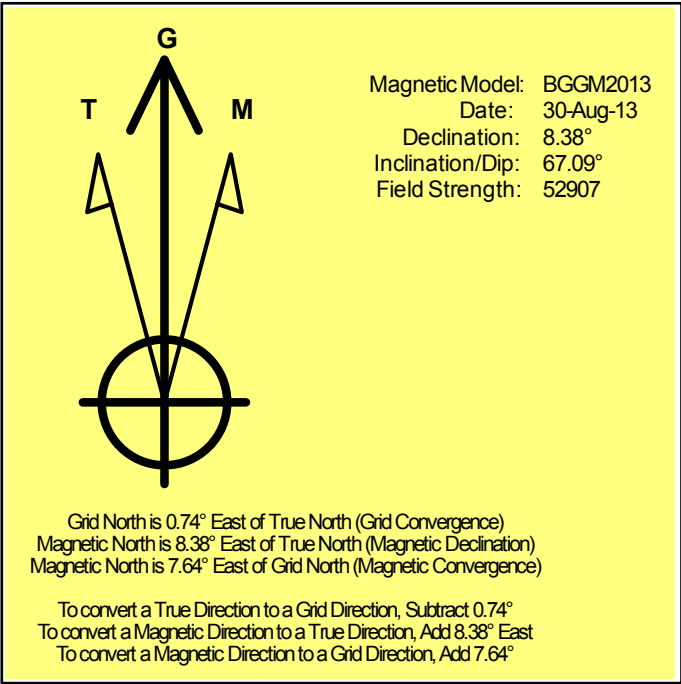

Noble Energy

Weld County, CO (NAD 83)

Sec. 20-T6N-R62W (Wells Ranch AE PAD)

Wells Ranch AE20-65HN - A9

Design: Final Surveys

Sperry Drilling Services

Geodetic Report

14 November, 2013

Well Coordinates: 1,416,113.31 N, 3,318,470.04 E (40° 28' 11.96" N, 104° 21' 19.12" W)

Ground Level: 4,785.00 usft

Local Coordinate Origin:

Viewing Datum:

TVDs to System:

North Reference:

Unit System:

Geodetic Scale Factor Applied

Version: 5000.1 Build: 70

Centered on Well Wells Ranch AE20-65HN - Slot A9

RKB 24 ft. @ 4809.00usft (H&P 343)

N

Grid

API - US Survey Feet - Custom

HALLIBURTON

Design Report for Wells Ranch AE20-65HN - Final Surveys

Measured			Vertical		Local Coordinates		Geographic Coordinates		UTM Coordinates	
Depth (usft)	Inclination (°)	Azimuth (°)	Depth (usft)		+N/-S (usft)	+E/-W (usft)	Latitude (usft)	Longitude (usft)	Northing (usft)	Easting (usft)
0.00	0.00	0.00	0.00		0.00	0.00	40° 28' 11.964 N	104° 21' 19.116 W	1,416,113.31	3,318,470.04
352.00	0.10	353.02	352.00		0.30	-0.04	40° 28' 11.967 N	104° 21' 19.116 W	1,416,113.61	3,318,470.00
631.00	1.60	190.82	630.97		-3.28	-0.80	40° 28' 11.932 N	104° 21' 19.127 W	1,416,110.03	3,318,469.24
943.00	1.00	175.82	942.88		-10.27	-1.42	40° 28' 11.863 N	104° 21' 19.136 W	1,416,103.03	3,318,468.62
1,086.00	1.05	152.00	1,085.86		-12.67	-0.71	40° 28' 11.839 N	104° 21' 19.127 W	1,416,100.63	3,318,469.32
1,179.00	1.29	206.16	1,178.85		-14.37	-0.77	40° 28' 11.822 N	104° 21' 19.128 W	1,416,098.94	3,318,469.26
1,272.00	0.95	67.52	1,271.84		-15.01	-0.52	40° 28' 11.816 N	104° 21' 19.125 W	1,416,098.29	3,318,469.51
1,364.00	2.52	31.33	1,363.79		-12.99	1.23	40° 28' 11.835 N	104° 21' 19.102 W	1,416,100.31	3,318,471.27
1,457.00	4.33	7.57	1,456.63		-7.76	2.76	40° 28' 11.887 N	104° 21' 19.082 W	1,416,105.54	3,318,472.80
1,552.00	6.94	2.60	1,551.16		1.53	3.49	40° 28' 11.979 N	104° 21' 19.071 W	1,416,114.83	3,318,473.53
1,647.00	8.61	354.64	1,645.29		14.34	3.09	40° 28' 12.105 N	104° 21' 19.074 W	1,416,127.65	3,318,473.12
1,742.00	8.89	1.38	1,739.19		28.76	2.60	40° 28' 12.248 N	104° 21' 19.078 W	1,416,142.06	3,318,472.64
1,837.00	10.13	2.18	1,832.88		44.45	3.10	40° 28' 12.403 N	104° 21' 19.068 W	1,416,157.75	3,318,473.13
1,931.00	12.00	359.65	1,925.13		62.48	3.35	40° 28' 12.581 N	104° 21' 19.062 W	1,416,175.78	3,318,473.39
2,026.00	13.07	355.38	2,017.86		83.06	2.43	40° 28' 12.784 N	104° 21' 19.071 W	1,416,196.37	3,318,472.46
2,121.00	13.39	359.83	2,110.34		104.77	1.53	40° 28' 12.999 N	104° 21' 19.079 W	1,416,218.07	3,318,471.56
2,216.00	14.95	0.59	2,202.45		128.03	1.62	40° 28' 13.229 N	104° 21' 19.074 W	1,416,241.33	3,318,471.66
2,311.00	15.15	359.42	2,294.19		152.69	1.62	40° 28' 13.473 N	104° 21' 19.069 W	1,416,265.99	3,318,471.66
2,406.00	14.99	359.38	2,385.93		177.39	1.36	40° 28' 13.717 N	104° 21' 19.069 W	1,416,290.69	3,318,471.40
2,501.00	15.23	359.31	2,477.64		202.15	1.08	40° 28' 13.961 N	104° 21' 19.068 W	1,416,315.45	3,318,471.12
2,596.00	17.16	3.03	2,568.87		228.63	1.67	40° 28' 14.223 N	104° 21' 19.056 W	1,416,341.93	3,318,471.71
2,691.00	14.84	1.50	2,660.18		254.79	2.73	40° 28' 14.481 N	104° 21' 19.038 W	1,416,368.08	3,318,472.77
2,786.00	15.68	359.75	2,751.83		279.79	2.99	40° 28' 14.728 N	104° 21' 19.031 W	1,416,393.08	3,318,473.03
2,881.00	16.39	357.61	2,843.14		306.02	2.38	40° 28' 14.987 N	104° 21' 19.034 W	1,416,419.31	3,318,472.41
2,976.00	15.79	358.12	2,934.42		332.33	1.39	40° 28' 15.247 N	104° 21' 19.042 W	1,416,445.62	3,318,471.43
3,071.00	14.07	357.66	3,026.21		356.79	0.50	40° 28' 15.489 N	104° 21' 19.050 W	1,416,470.08	3,318,470.53
3,166.00	14.97	359.01	3,118.17		380.59	-0.18	40° 28' 15.725 N	104° 21' 19.055 W	1,416,493.88	3,318,469.85
3,261.00	14.67	2.24	3,210.01		404.88	0.07	40° 28' 15.965 N	104° 21' 19.047 W	1,416,518.17	3,318,470.11
3,356.00	14.07	359.26	3,302.04		428.45	0.39	40° 28' 16.197 N	104° 21' 19.039 W	1,416,541.74	3,318,470.43
3,451.00	13.37	3.83	3,394.33		450.96	0.98	40° 28' 16.420 N	104° 21' 19.028 W	1,416,564.24	3,318,471.01
3,545.00	13.61	5.23	3,485.74		472.81	2.71	40° 28' 16.635 N	104° 21' 19.002 W	1,416,586.10	3,318,472.75
3,640.00	15.77	5.66	3,577.63		496.79	5.01	40° 28' 16.872 N	104° 21' 18.968 W	1,416,610.08	3,318,475.04
3,735.00	18.16	4.20	3,668.49		524.41	7.36	40° 28' 17.145 N	104° 21' 18.933 W	1,416,637.70	3,318,477.40
3,830.00	19.61	3.89	3,758.37		555.08	9.53	40° 28' 17.447 N	104° 21' 18.900 W	1,416,668.37	3,318,479.56
3,925.00	21.80	4.39	3,847.23		588.58	11.96	40° 28' 17.778 N	104° 21' 18.863 W	1,416,701.86	3,318,482.00
4,020.00	20.15	0.71	3,935.94		622.53	13.51	40° 28' 18.113 N	104° 21' 18.837 W	1,416,735.81	3,318,483.55
4,115.00	17.37	358.13	4,025.88		653.07	13.25	40° 28' 18.415 N	104° 21' 18.835 W	1,416,766.35	3,318,483.29
4,210.00	14.00	354.38	4,117.33		678.69	11.67	40° 28' 18.668 N	104° 21' 18.852 W	1,416,791.97	3,318,481.70
4,305.00	11.02	354.80	4,210.07		699.17	9.72	40° 28' 18.871 N	104° 21' 18.873 W	1,416,812.45	3,318,479.75
4,399.00	11.45	352.80	4,302.27		717.38	7.73	40° 28' 19.051 N	104° 21' 18.896 W	1,416,830.66	3,318,477.77
4,494.00	12.93	353.11	4,395.12		737.28	5.28	40° 28' 19.248 N	104° 21' 18.925 W	1,416,850.56	3,318,475.31
4,589.00	10.78	347.64	4,488.09		756.52	2.10	40° 28' 19.439 N	104° 21' 18.962 W	1,416,869.80	3,318,472.13

Design Report for Wells Ranch AE20-65HN - Final Surveys

Measured Depth (usft)	Inclination (°)	Azimuth (°)	Vertical Depth (usft)	Local Coordinates		Geographic Coordinates		UTM Coordinates	
				+N/-S (usft)	+E/-W (usft)	Latitude (usft)	Longitude (usft)	Northing (usft)	Easting (usft)
4,684.00	8.94	358.55	4,581.69	772.58	0.01	40° 28' 19.598 N	104° 21' 18.987 W	1,416,885.86	3,318,470.05
4,779.00	7.66	353.09	4,675.70	786.24	-0.94	40° 28' 19.733 N	104° 21' 18.997 W	1,416,899.52	3,318,469.10
4,874.00	7.28	351.47	4,769.89	798.48	-2.59	40° 28' 19.854 N	104° 21' 19.016 W	1,416,911.76	3,318,467.44
4,969.00	7.04	355.03	4,864.15	810.23	-3.99	40° 28' 19.970 N	104° 21' 19.032 W	1,416,923.51	3,318,466.05
5,061.00	7.30	352.59	4,955.43	821.65	-5.23	40° 28' 20.083 N	104° 21' 19.046 W	1,416,934.92	3,318,464.80
5,156.00	8.04	356.65	5,049.58	834.26	-6.40	40° 28' 20.208 N	104° 21' 19.059 W	1,416,947.54	3,318,463.64
5,251.00	7.36	354.93	5,143.73	846.96	-7.32	40° 28' 20.333 N	104° 21' 19.069 W	1,416,960.23	3,318,462.71
5,346.00	6.60	354.58	5,238.02	858.45	-8.38	40° 28' 20.447 N	104° 21' 19.081 W	1,416,971.73	3,318,461.66
5,440.00	7.58	356.44	5,331.30	870.02	-9.27	40° 28' 20.562 N	104° 21' 19.091 W	1,416,983.29	3,318,460.76
5,535.00	6.08	355.39	5,425.62	881.29	-10.07	40° 28' 20.673 N	104° 21' 19.099 W	1,416,994.56	3,318,459.97
5,630.00	5.09	355.83	5,520.17	890.51	-10.78	40° 28' 20.764 N	104° 21' 19.107 W	1,417,003.78	3,318,459.26
5,725.00	3.21	346.81	5,614.92	897.30	-11.69	40° 28' 20.831 N	104° 21' 19.117 W	1,417,010.57	3,318,458.34
5,820.00	1.87	357.77	5,709.82	901.44	-12.36	40° 28' 20.872 N	104° 21' 19.125 W	1,417,014.71	3,318,457.68
5,915.00	2.22	23.36	5,804.77	904.68	-11.69	40° 28' 20.904 N	104° 21' 19.116 W	1,417,017.95	3,318,458.35
6,010.00	7.54	82.73	5,899.43	907.16	-4.77	40° 28' 20.928 N	104° 21' 19.026 W	1,417,020.43	3,318,465.27
6,057.00	13.79	87.85	5,945.59	907.76	3.90	40° 28' 20.933 N	104° 21' 18.914 W	1,417,021.03	3,318,473.93
6,105.00	16.26	90.01	5,991.95	907.97	16.33	40° 28' 20.933 N	104° 21' 18.753 W	1,417,021.25	3,318,486.37
6,152.00	18.74	90.13	6,036.77	907.95	30.47	40° 28' 20.931 N	104° 21' 18.570 W	1,417,021.23	3,318,500.50
6,200.00	20.65	91.37	6,081.96	907.73	46.64	40° 28' 20.927 N	104° 21' 18.361 W	1,417,021.01	3,318,516.67
6,247.00	23.25	91.69	6,125.55	907.26	64.20	40° 28' 20.920 N	104° 21' 18.134 W	1,417,020.54	3,318,534.23
6,295.00	26.35	91.44	6,169.12	906.72	84.32	40° 28' 20.912 N	104° 21' 17.874 W	1,417,019.99	3,318,554.36
6,342.00	29.84	90.88	6,210.57	906.27	106.45	40° 28' 20.905 N	104° 21' 17.587 W	1,417,019.55	3,318,576.48
6,390.00	33.77	89.57	6,251.36	906.19	131.74	40° 28' 20.901 N	104° 21' 17.260 W	1,417,019.46	3,318,601.77
6,437.00	37.71	89.51	6,289.50	906.41	159.19	40° 28' 20.900 N	104° 21' 16.905 W	1,417,019.68	3,318,629.22
6,485.00	42.85	88.98	6,326.11	906.83	190.21	40° 28' 20.900 N	104° 21' 16.504 W	1,417,020.10	3,318,660.24
6,532.00	48.11	89.35	6,359.05	907.31	223.70	40° 28' 20.900 N	104° 21' 16.070 W	1,417,020.58	3,318,693.73
6,579.00	51.93	90.04	6,389.24	907.50	259.71	40° 28' 20.898 N	104° 21' 15.604 W	1,417,020.77	3,318,729.74
6,626.00	55.23	89.98	6,417.14	907.49	297.53	40° 28' 20.893 N	104° 21' 15.115 W	1,417,020.76	3,318,767.55
6,674.00	58.77	90.07	6,443.28	907.47	337.78	40° 28' 20.887 N	104° 21' 14.594 W	1,417,020.74	3,318,807.80
6,721.00	63.28	88.87	6,466.04	907.86	378.88	40° 28' 20.886 N	104° 21' 14.062 W	1,417,021.13	3,318,848.90
6,769.00	66.94	88.91	6,486.24	908.70	422.41	40° 28' 20.889 N	104° 21' 13.499 W	1,417,021.98	3,318,892.43
6,816.00	72.01	90.64	6,502.72	908.87	466.41	40° 28' 20.885 N	104° 21' 12.930 W	1,417,022.14	3,318,936.42
6,864.00	76.41	90.70	6,515.78	908.33	512.58	40° 28' 20.873 N	104° 21' 12.332 W	1,417,021.60	3,318,982.60
6,912.00	81.75	89.58	6,524.87	908.22	559.69	40° 28' 20.866 N	104° 21' 11.723 W	1,417,021.49	3,319,029.71
6,957.00	83.11	88.78	6,530.79	908.86	604.29	40° 28' 20.867 N	104° 21' 11.146 W	1,417,022.13	3,319,074.31
7,039.00	85.59	87.32	6,538.87	911.64	685.84	40° 28' 20.884 N	104° 21' 10.090 W	1,417,024.91	3,319,155.85
7,134.00	89.26	88.10	6,543.13	915.43	780.65	40° 28' 20.909 N	104° 21' 8.863 W	1,417,028.70	3,319,250.66
7,229.00	91.42	88.57	6,542.57	918.19	875.60	40° 28' 20.925 N	104° 21' 7.634 W	1,417,031.46	3,319,345.61
7,324.00	93.67	87.23	6,538.35	921.66	970.44	40° 28' 20.947 N	104° 21' 6.406 W	1,417,034.94	3,319,440.44
7,419.00	92.72	86.65	6,533.06	926.73	1,065.15	40° 28' 20.985 N	104° 21' 5.180 W	1,417,040.00	3,319,535.15
7,514.00	87.84	82.50	6,532.59	935.71	1,159.68	40° 28' 21.061 N	104° 21' 3.956 W	1,417,048.98	3,319,629.67
7,609.00	88.92	81.43	6,535.28	948.98	1,253.70	40° 28' 21.180 N	104° 21' 2.737 W	1,417,062.25	3,319,723.69

Design Report for Wells Ranch AE20-65HN - Final Surveys

Measured Depth (usft)	Inclination (°)	Azimuth (°)	Vertical Depth (usft)	Local Coordinates		Geographic Coordinates		UTM Coordinates	
				+N/-S (usft)	+E/-W (usft)	Latitude (usft)	Longitude (usft)	Northing (usft)	Easting (usft)
7,704.00	86.89	86.77	6,538.75	958.74	1,348.10	40° 28' 21.265 N	104° 21' 1.514 W	1,417,072.01	3,319,818.09
7,799.00	89.51	86.43	6,541.74	964.37	1,442.88	40° 28' 21.308 N	104° 21' 0.287 W	1,417,077.64	3,319,912.86
7,894.00	90.80	87.86	6,541.48	969.10	1,537.75	40° 28' 21.343 N	104° 20' 59.058 W	1,417,082.37	3,320,007.73
7,989.00	91.20	89.16	6,539.82	971.57	1,632.70	40° 28' 21.355 N	104° 20' 57.829 W	1,417,084.84	3,320,102.68
8,084.00	89.97	88.80	6,538.85	973.26	1,727.68	40° 28' 21.360 N	104° 20' 56.600 W	1,417,086.53	3,320,197.66
8,179.00	88.49	88.12	6,540.13	975.81	1,822.64	40° 28' 21.373 N	104° 20' 55.371 W	1,417,089.08	3,320,292.61
8,274.00	88.95	89.64	6,542.25	977.67	1,917.59	40° 28' 21.379 N	104° 20' 54.142 W	1,417,090.94	3,320,387.56
8,369.00	88.55	90.86	6,544.32	977.26	2,012.57	40° 28' 21.362 N	104° 20' 52.914 W	1,417,090.53	3,320,482.53
8,464.00	89.11	89.99	6,546.26	976.55	2,107.54	40° 28' 21.343 N	104° 20' 51.685 W	1,417,089.82	3,320,577.50
8,559.00	89.57	90.49	6,547.36	976.15	2,202.53	40° 28' 21.327 N	104° 20' 50.456 W	1,417,089.42	3,320,672.49
8,654.00	90.77	89.59	6,547.08	976.09	2,297.53	40° 28' 21.314 N	104° 20' 49.227 W	1,417,089.36	3,320,767.48
8,749.00	90.56	89.66	6,545.97	976.71	2,392.52	40° 28' 21.308 N	104° 20' 47.998 W	1,417,089.98	3,320,862.47
8,843.00	90.86	90.54	6,544.81	976.54	2,486.51	40° 28' 21.295 N	104° 20' 46.782 W	1,417,089.81	3,320,956.46
8,938.00	89.41	89.69	6,544.59	976.35	2,581.51	40° 28' 21.280 N	104° 20' 45.553 W	1,417,089.62	3,321,051.45
9,033.00	88.00	90.83	6,546.73	975.92	2,676.48	40° 28' 21.264 N	104° 20' 44.324 W	1,417,089.19	3,321,146.42
9,128.00	88.06	90.05	6,550.00	975.19	2,771.42	40° 28' 21.245 N	104° 20' 43.096 W	1,417,088.46	3,321,241.36
9,223.00	88.77	89.07	6,552.63	975.92	2,866.38	40° 28' 21.240 N	104° 20' 41.867 W	1,417,089.19	3,321,336.31
9,318.00	89.23	87.51	6,554.28	978.76	2,961.32	40° 28' 21.255 N	104° 20' 40.638 W	1,417,092.03	3,321,431.25
9,413.00	88.71	89.77	6,555.99	981.01	3,056.27	40° 28' 21.265 N	104° 20' 39.409 W	1,417,094.28	3,321,526.20
9,508.00	89.54	88.76	6,557.44	982.23	3,151.25	40° 28' 21.265 N	104° 20' 38.180 W	1,417,095.50	3,321,621.17
9,603.00	89.54	90.58	6,558.21	982.78	3,246.24	40° 28' 21.258 N	104° 20' 36.951 W	1,417,096.05	3,321,716.16
9,698.00	89.88	90.03	6,558.69	982.27	3,341.24	40° 28' 21.241 N	104° 20' 35.722 W	1,417,095.54	3,321,811.16
9,793.00	91.45	91.63	6,557.58	980.90	3,436.22	40° 28' 21.215 N	104° 20' 34.494 W	1,417,094.17	3,321,906.13
9,888.00	89.04	90.68	6,557.18	978.98	3,531.19	40° 28' 21.184 N	104° 20' 33.265 W	1,417,092.25	3,322,001.10
9,983.00	89.23	92.89	6,558.61	976.02	3,626.13	40° 28' 21.143 N	104° 20' 32.037 W	1,417,089.29	3,322,096.03
10,078.00	91.29	105.90	6,558.18	960.55	3,719.64	40° 28' 20.978 N	104° 20' 30.830 W	1,417,073.82	3,322,189.55
10,172.00	89.48	97.92	6,557.55	941.17	3,811.54	40° 28' 20.774 N	104° 20' 29.644 W	1,417,054.44	3,322,281.44
10,267.00	89.01	92.88	6,558.80	932.23	3,906.08	40° 28' 20.674 N	104° 20' 28.423 W	1,417,045.50	3,322,375.98
10,362.00	89.32	90.18	6,560.18	929.70	4,001.03	40° 28' 20.636 N	104° 20' 27.195 W	1,417,042.97	3,322,470.92
10,457.00	89.54	88.86	6,561.13	930.49	4,096.02	40° 28' 20.632 N	104° 20' 25.966 W	1,417,043.76	3,322,565.91
10,552.00	90.71	86.73	6,560.92	934.15	4,190.94	40° 28' 20.656 N	104° 20' 24.737 W	1,417,047.42	3,322,660.83
10,647.00	90.49	86.00	6,559.93	940.17	4,285.74	40° 28' 20.703 N	104° 20' 23.509 W	1,417,053.44	3,322,755.62
10,762.00	88.98	84.06	6,560.46	950.13	4,400.30	40° 28' 20.787 N	104° 20' 22.025 W	1,417,063.40	3,322,870.18
10,826.00	88.98	84.06	6,561.60	956.75	4,463.95	40° 28' 20.844 N	104° 20' 21.201 W	1,417,070.02	3,322,933.82

Design Report for Wells Ranch AE20-65HN - Final Surveys

Design Annotations

Measured Depth (usft)	Vertical Depth (usft)	Local Coordinates		Comment
		+N/-S (usft)	+E/-W (usft)	
943.00	942.88	-10.27	-1.42	Tie-On to Surface Gyros @ 943.00ft
1,086.00	1,085.86	-12.67	-0.71	First MWD Survey @ 1086.00ft
10,762.00	6,560.46	950.13	4,400.30	Final MWD Survey @ 10762.00ft
10,826.00	6,561.60	956.75	4,463.95	Straight Line Proj @ 10826' MD, 6561.60' TVD

Vertical Section Information

Angle Type	Target	Azimuth (°)	Origin Type	Origin		Start TVD (usft)
				+N/_S (usft)	+E/-W (usft)	
Target	Wells Ranch AE20-65HN (PA_RA0) BHL	77.84	Slot	0.00	0.00	0.00

Survey tool program

From (usft)	To (usft)	Survey/Plan	Survey Tool
352.00	943.00	Surface Gyros	Flexi-Shot
1,086.00	6,912.00	MWD Surveys - Vert/Build	MWD+IFR1+MS_WY
7,039.00	10,762.00	MWD Surveys - Lateral	MWD+IFR1+MS_WY

Casing Details

Measured Depth (usft)	Vertical Depth (usft)	Name	Casing Diameter (")	Hole Diameter (")
6,957.00	6,530.79	7" Casing @ 6957' MD, 6530.79' TVD	7	8-3/4

Design Report for Wells Ranch AE20-65HN - Final Surveys

Design Targets

Shape	Target Name	TVD ()	Northing ()	Easting ()	+N/-S	+E/-W	Created	Updated
-------	-------------	------------	-----------------	----------------	-------	-------	---------	---------

Directional Difficulty Index

Average Dogleg over Survey:	2.39 °/100usft	Maximum Dogleg over Survey:	13.86 °/100usft at 10,078.00 usft
Net Tortousity applicable to Plans:	1.28 °/100usft	Directional Difficulty Index:	6.365

Audit Info

North Reference Sheet for Sec. 20-T6N-R62W (Wells Ranch AE PAD) - Wells Ranch AE20-65HN

All data is in US Feet unless otherwise stated. Directions and Coordinates are relative to Grid North Reference.

Vertical Depths are relative to RKB 24 ft. @ 4809.00usft (H&P 343). Northing and Easting are relative to Wells Ranch AE20-65HN - Slot A9

Coordinate System is US State Plane 1983, Colorado Northern Zone using datum North American Datum 1983, ellipsoid GRS 1980

Projection method is Lambert Conformal Conic (2 parallel)

Central Meridian is 105° 30' 0.000 W°, Longitude Origin:0° 0' 0.000 E°, Latitude Origin:40° 47' 0.000 N°

False Easting: 3,000,000.00usft, False Northing: 1,000,000.00usft, Scale Reduction: 0.99996415

Grid Coordinates of Well: 1,416,113.31 usft N, 3,318,470.04 usft E

Geographical Coordinates of Well: 40° 28' 11.96" N, 104° 21' 19.12" W

Grid Convergence at Surface is: 0.74°

Based upon Minimum Curvature type calculations, at a Measured Depth of 10,826.00usft

the Bottom Hole Displacement is 4,565.33usft in the Direction of 77.90° (Grid).

Magnetic Convergence at surface is: -7.64° (30 August 2013, , BGGM2013)

