


**WPX Energy Rocky Mountain LLC  
FEDERAL PA 442-21  
Parachute Field**

**SHL 2610' FNL 1463' FWL (SE/4 NW/4) Section 21 T6S R95W 6th PM  
BHL 2290' FNL 316' FEL (SE/4 NE/4) Section 21 T6S R95W 6th PM  
Garfield County Colorado**

**Formation Tops  
(Measured Depths)**

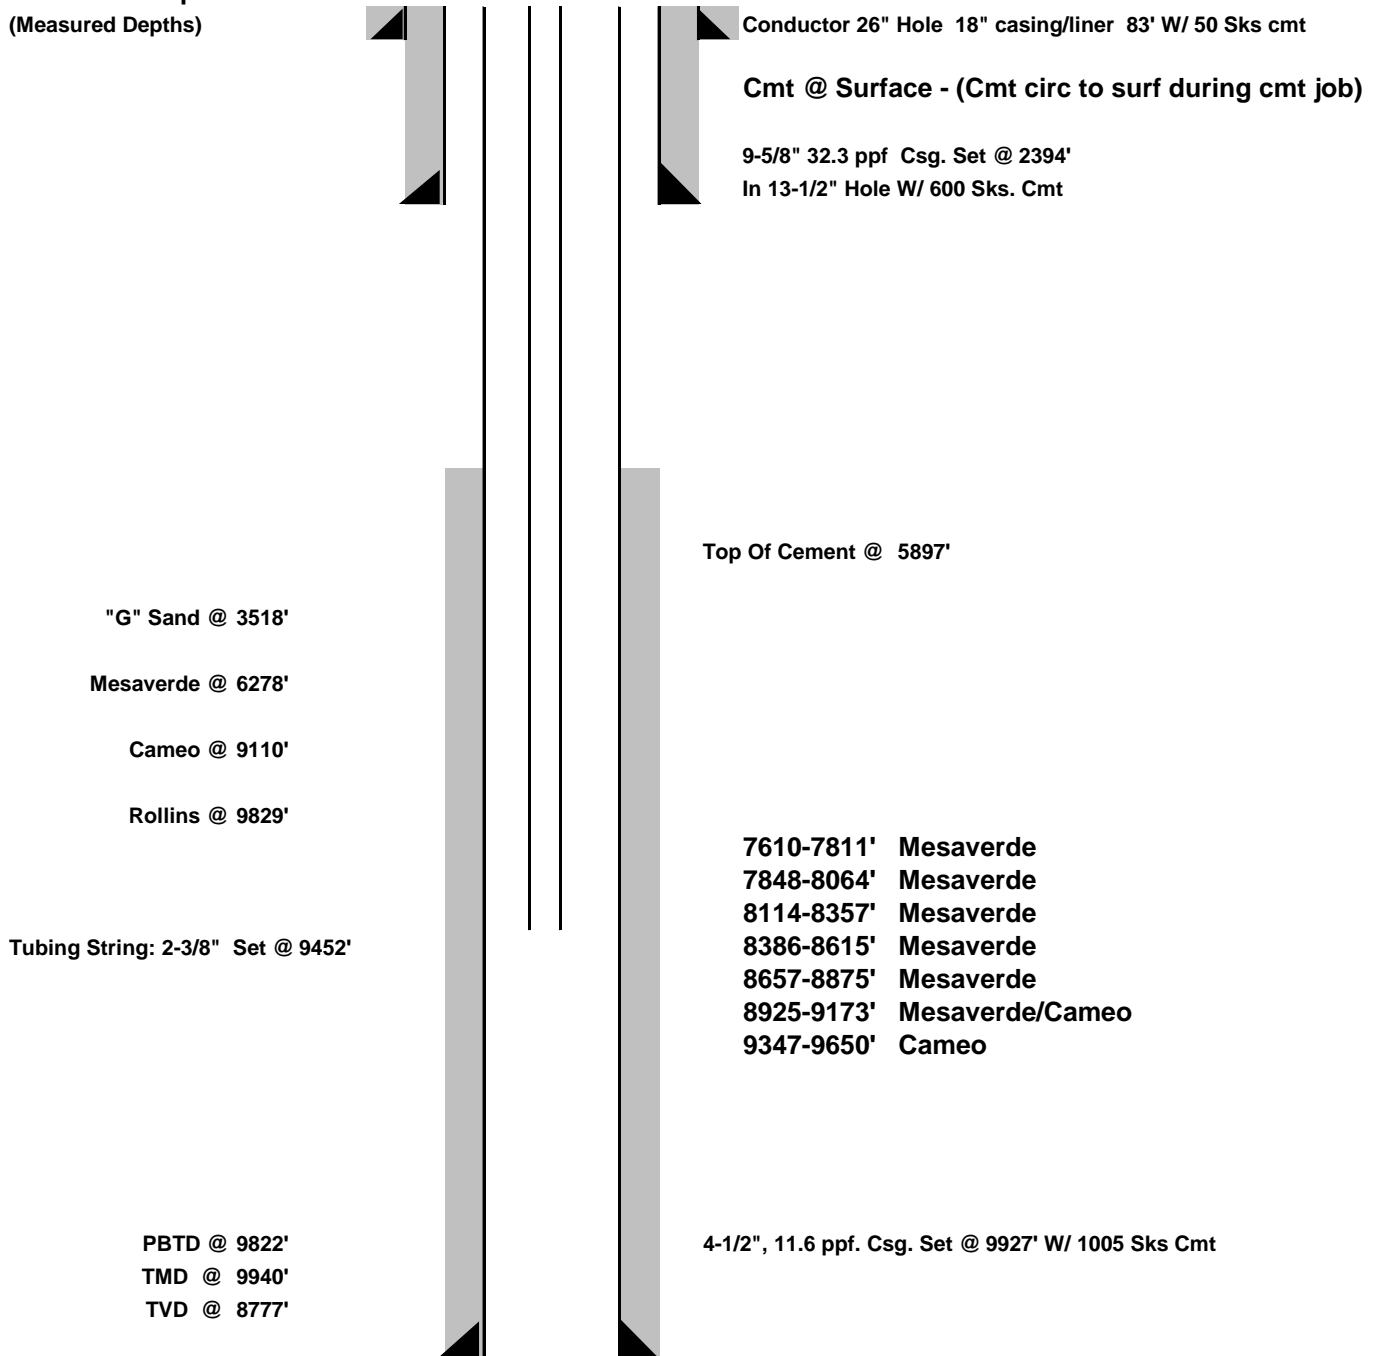

**DATE CREATED: 3/17/2014**

**NOTE: THIS IS NOT TO SCALE.**  
**\*\*FINAL\*\***