

# Energy Minerals Unit B #1

Latitude/Longitude: N40.11101000, W -104.89336000:


Township/Range: 28 002-N

Swne-28-2N-67W

County: Weld, State: CO

Spud Date: 12/30/1980

Total Depth: 4850

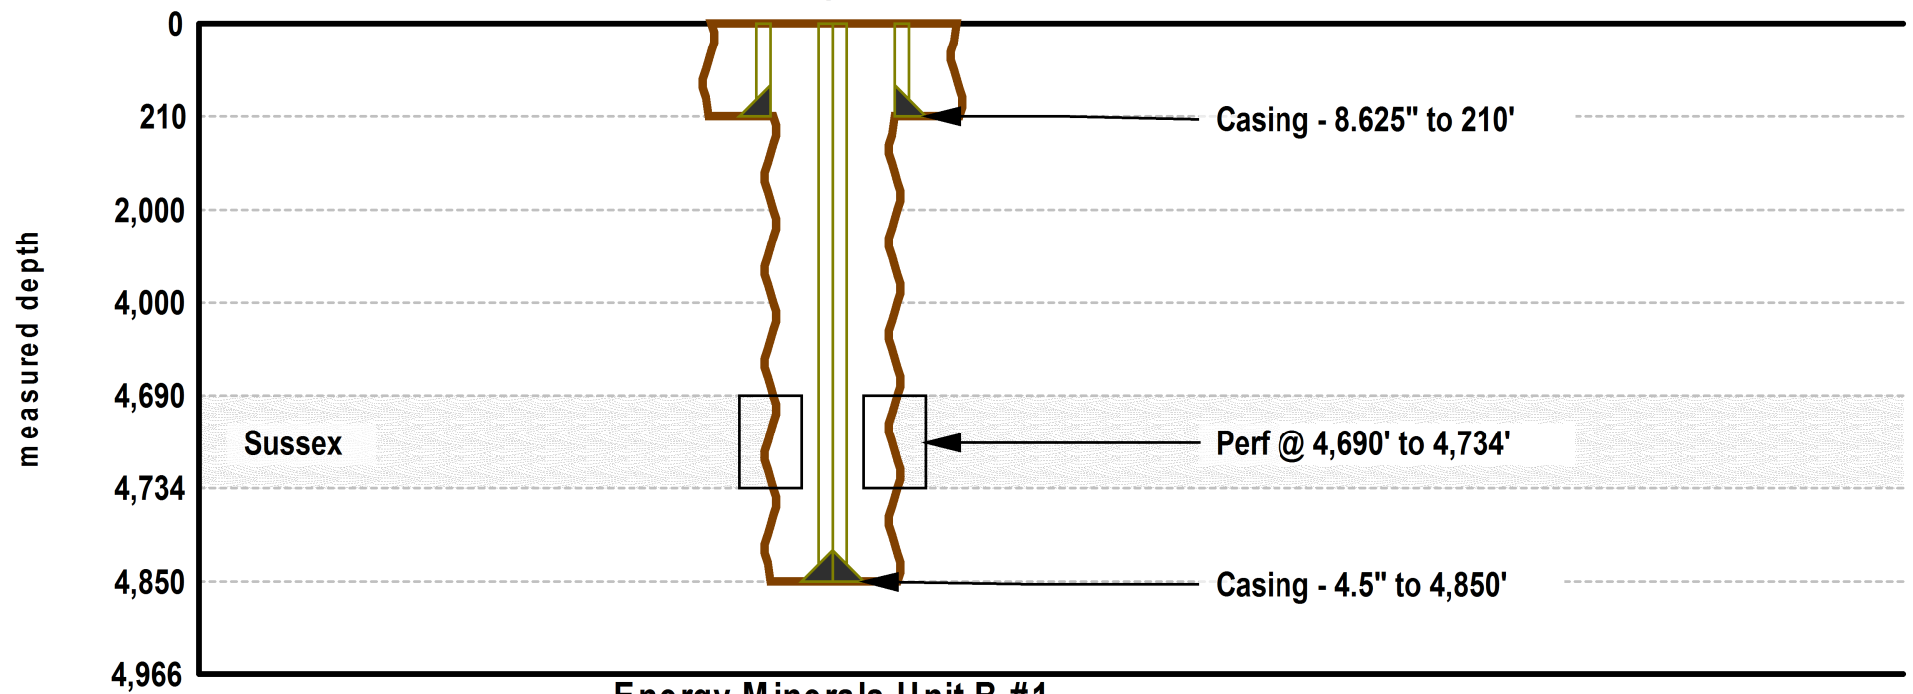

Energy Minerals Unit B #1

Initial Completion: 2/28/1981

Proposed Depth: 4800 Plug Back Depth: 4802