

KERR-MCGEE OIL AND GAS ONSHORE LP

CLC GU 1

NE SW 18 2N 66W 1,650' FSL 1,750' FWL

WELD,COLORADO

03/10/2014

AREA: E3

ROUTE: E32

Spud: 01/16/1975

WINS No.: 75084

AFE/WO#: 88478651

API#: 0512308230

GL: 4850

KB: 4861

MTD: 7950


TVD: 7950

LOG MD: 7951

PBMD: 7908

PBTVD: 7908

Directions: HWY 85 & CR 22, S 7/10, W 3/10, N 2/10, W 2/10 INTO.

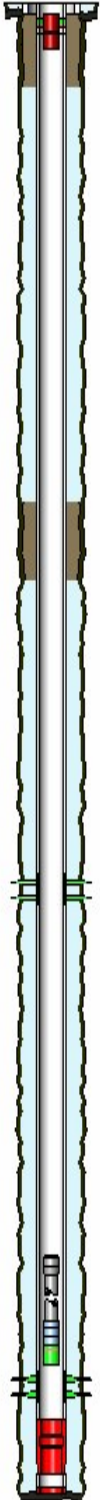

<u>HOLE SECTIONS</u>	<u>Size</u>	<u>Top</u>	<u>Btm</u>	<u>TD Date</u>				
SURFACE	12.25	11	280	01/17/1975				
PRODUCTION	7.88	244	7950	01/23/1975				

<u>TUBULARS</u>	<u>Tool Type</u>	<u>Joints</u>	<u>Size</u>	<u>Weight</u>	<u>Grade</u>	<u>Thread</u>	<u>Top D</u>	<u>Bottom D</u>
SURFACE CASING	Casing	6	8.63	24.00	J-55	STC	11	244
PRODUCTION CASING	Casing	24	4.50	11.60	K-55	LTC	11	702
	Cement Stage Too	1	4.50		K-55		702	705
	Casing	28	4.50	11.60	J-55	LTC	705	1725
	Casing	195	4.50	10.50	K-55	LTC	1725	7908
	Casing Float Collar	1	4.50				7908	7910
	Casing	1	4.50	10.50	K-55	LTC	7910	7945
	Casing Guide Shoe	1	4.50				7945	7946
PRODUCTION TUBING	Tubing	249	2.37	4.70	J-55	8RD EUE	7782	7782
	Notched Collar	1	2.38				7783	7783
PRODUCTION TUBING	Wellbore Equipment	206	2.38		J-55		12	6436
	Wellbore Equipment	1	2.38				6436	6437

<u>CEMENT JOBS</u>	<u>Stage</u>	<u>Sacks</u>	<u>Cement Jobs</u>	<u>Top D</u>	<u>Btm D</u>	<u>cbl</u>
SURFACE CASING	STAGE 1	250	G	11	244	No
PRODUCTION CASING	STAGE 1	300	50/50 POZ-MIX	7040	7946	Yes
	STAGE 2	150	50/50 POZ-MIX	124	702	Yes
--None--	SQUEEZE JOB			6480	6950	Yes

<u>PERFORATIONS</u>	<u>Formation</u>	<u>Zone</u>	<u>Top</u>	<u>Btm</u>	<u>Date</u>	<u>Reason</u>	<u>Comments</u>
	NIOBRARA	B	6600	6601	02/28/2014	CEMENT SQUEEZE	
	NIOBRARA	C	6950	6951	02/28/2014	CEMENT SQUEEZE	
	CODELL		7374	7384	08/01/1994	PRODUCTION	2 SPF
	J SAND	J-Sand	7822	7860	10/11/1975	PRODUCTION	1 SPF

Comments: