

WELLBORE DIAGRAM

Gustafson #1

API#: 05-123-05306

1989' FSL & 1940' FWL


Lat. 40.539463, Long. -104.623008

Weld County CO

G.L.= 4822

K.B.= 4834

12

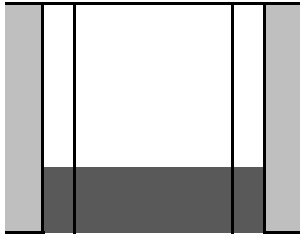

25 Sack plug from 371 - 359'

10 3/4" 40.5# set at 375' (13 3/4 O.H.)

Cmt'd w/220 sx

TOC: 157' CBL

25 Sacks of Cement from 7580 - 7530

25 Sacks of Cement from 8919 - 8869

TD @ 9,045'

9" Open Hole, no Casing Run