

CUNDALL 5-12
SWNW, Section 12-T1S-R68W
Adams County, CO
API No. 05-001-09492

Ground Elevation = 5,091'

KB Elevation = 5,107'

NOTE: Well is vertical well

Tubing Detail:

Jts	Desc	Length	Depth; ft
-----	------	--------	-----------

Need to obtain from field office


Rod Detail:

Jts	Desc	Length	Depth
-----	------	--------	-------

Need to obtain from field office

Treatment Desc:

7/1/2004 Frac Codell w/ 245,000# 20/40 sand and 3,150 bbls gelled water

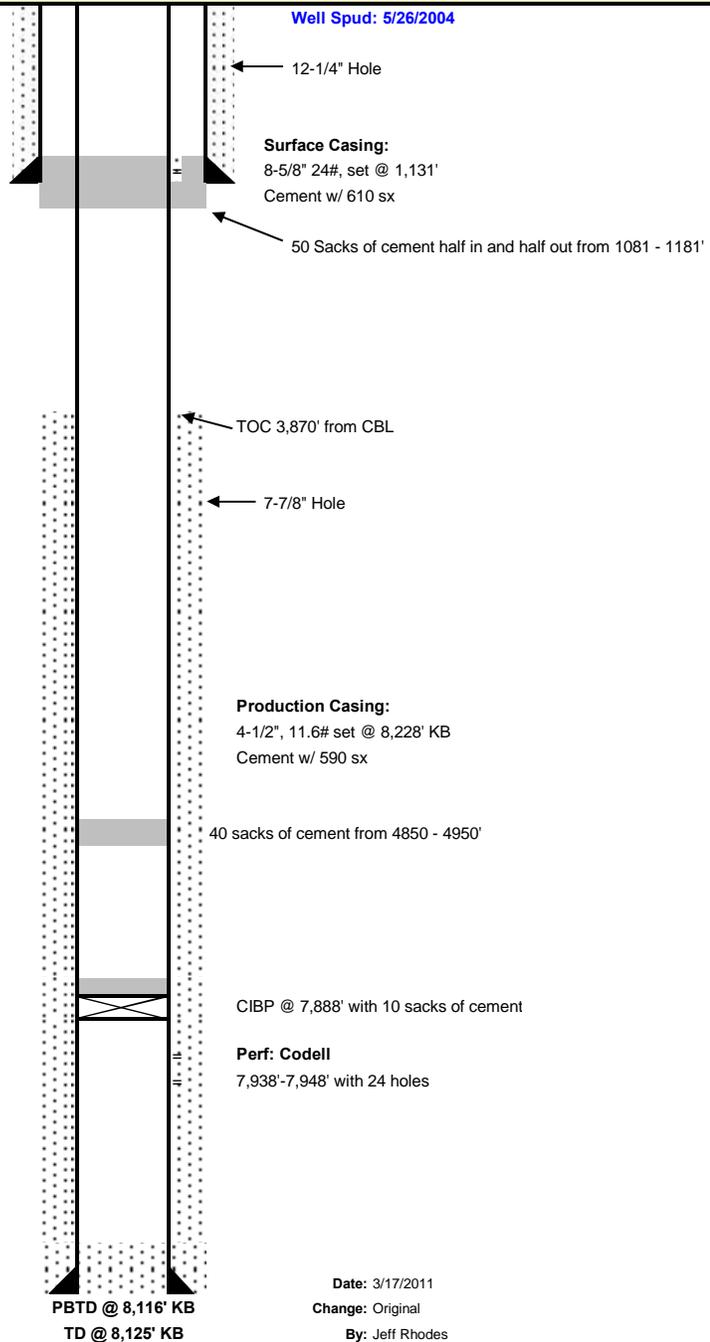

Date: 3/17/2011
 Change: Original
 By: Jeff Rhodes