


CURRENT WELLBORE DIAGRAM

FREGEAU 1

API # 051230577900

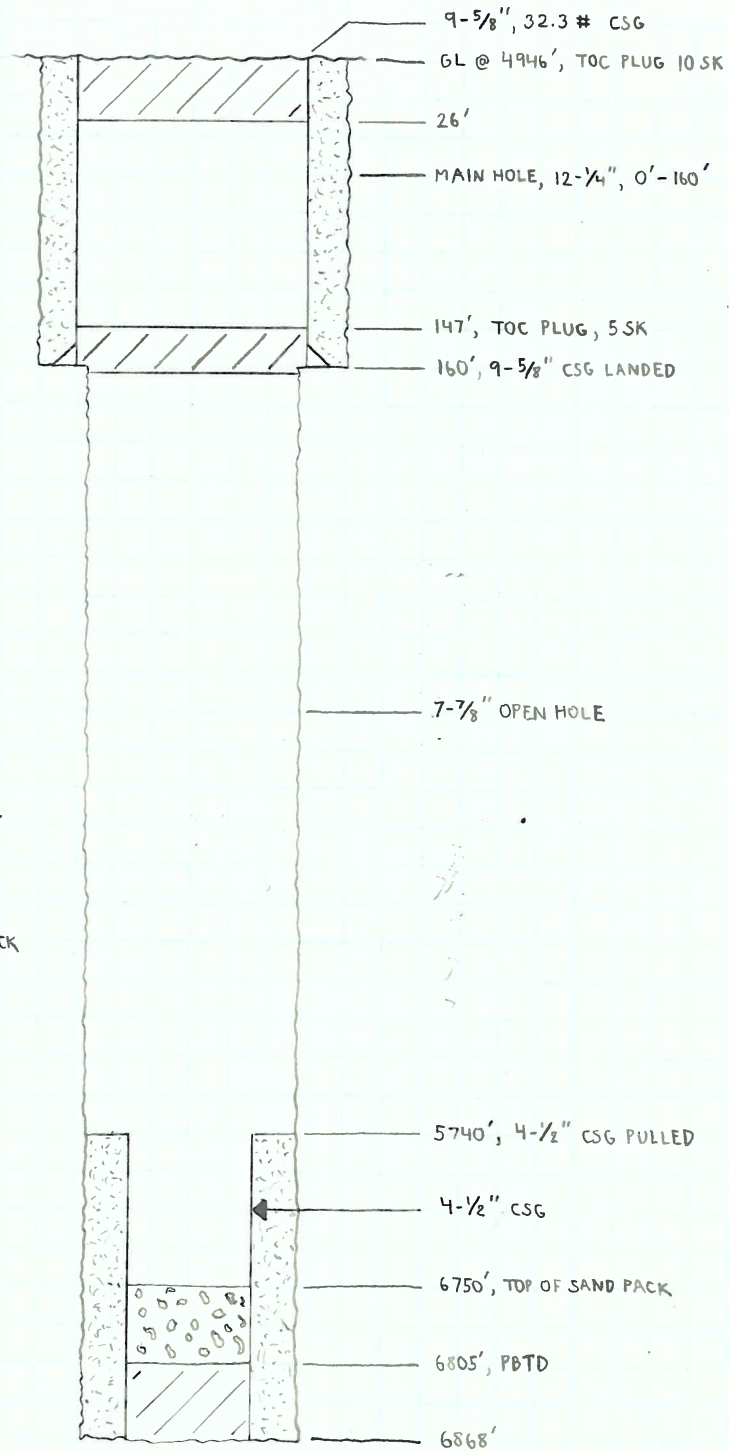

- EXISTING PRIMARY CEMENT



- EXISTING CEMENT PLUG



- EXISTING SAND PACK