

WELL NAME:

OPERATOR:

COMP ZONE:

LOCATION:

Durland Trust #1

Arnold H.C. - 4200

J Sand

10N 57W S5 SESW

COUNTY:

STATE:

API :

Weld

Colorado

05-123-05006

SPUD:


P&A:

GL:

8/26/55

9/10/55

4,935'

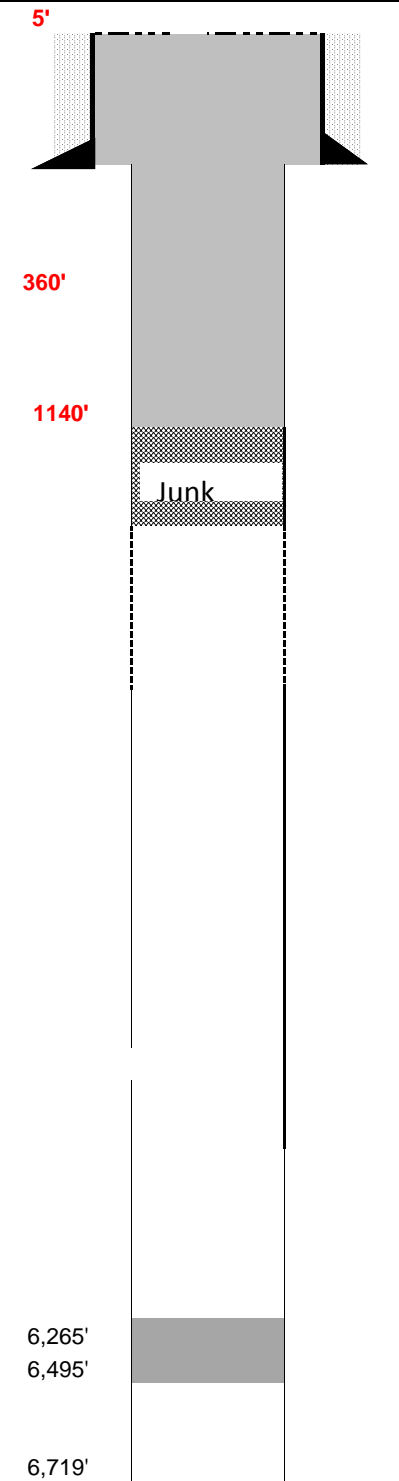

**SURFACE CASING**

DEPTH: 37'    SIZE: 8 5/8"    GRADE: Unk    WT (#/ft): 14.0

CEMENT: 50 sacks

COMMENTS:

**PRODUCTION CASING**

DEPTH:    SIZE:    GRADE:    WT (#/ft):

CEMENT:    TOC:

COMMENTS: 7 7/8" Hole

PERFS:    -    PROD ZONE 1:

PERFS:    -    ZONE 2:

PERFS:    -    ZONE 3:

**PREVIOUS PLUGS**

RECOVERED:    SIZE:

CMT 1: 6,495' - 6,265'    COMMENT: 40 sk cement plug

CMT 2: 0' - 37'    COMMENT: 10 sk cement plug at surface

CMT 3:    -    COMMENT:

OTHER: Plug #1: 1140' to 360' (150 sx)

Plug #2: 360' to surface (250 sx)

**FORMATIONS:**

NIOBRARA: 5,656'

GRANEROS 6,293'

D SAND: 6,497'

J SAND: 6,594'

SKULL CR. 6,686'